


T. 4 S., R. 2 W. W.M.

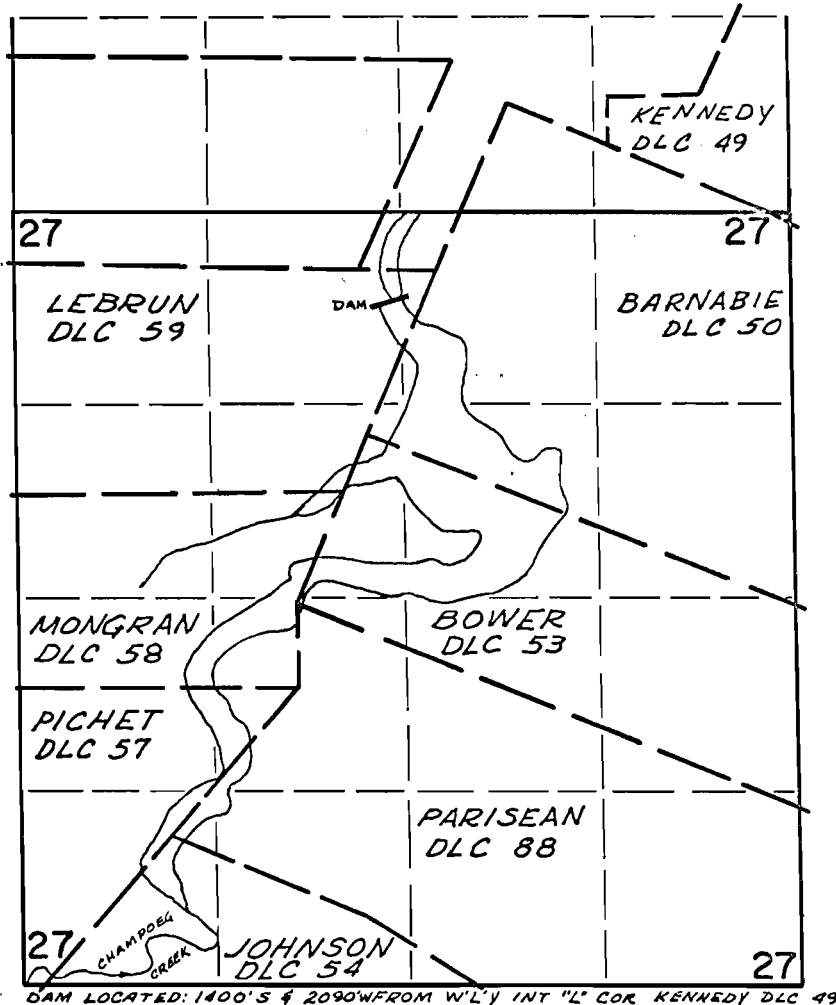

FINAL PROOF SURVEY
UNDER

Application No. R-44853 R-43213 Permit No. R-5287 R-5064

IN NAME OF

ARTHUR McKAY, WALTER
WILMES, PATRICK JOHNSTON & estate of NEAL MILLER

Surveyed Oct. 2 1972, by D. Norby