


T.4 S., R.2 W. W.M.

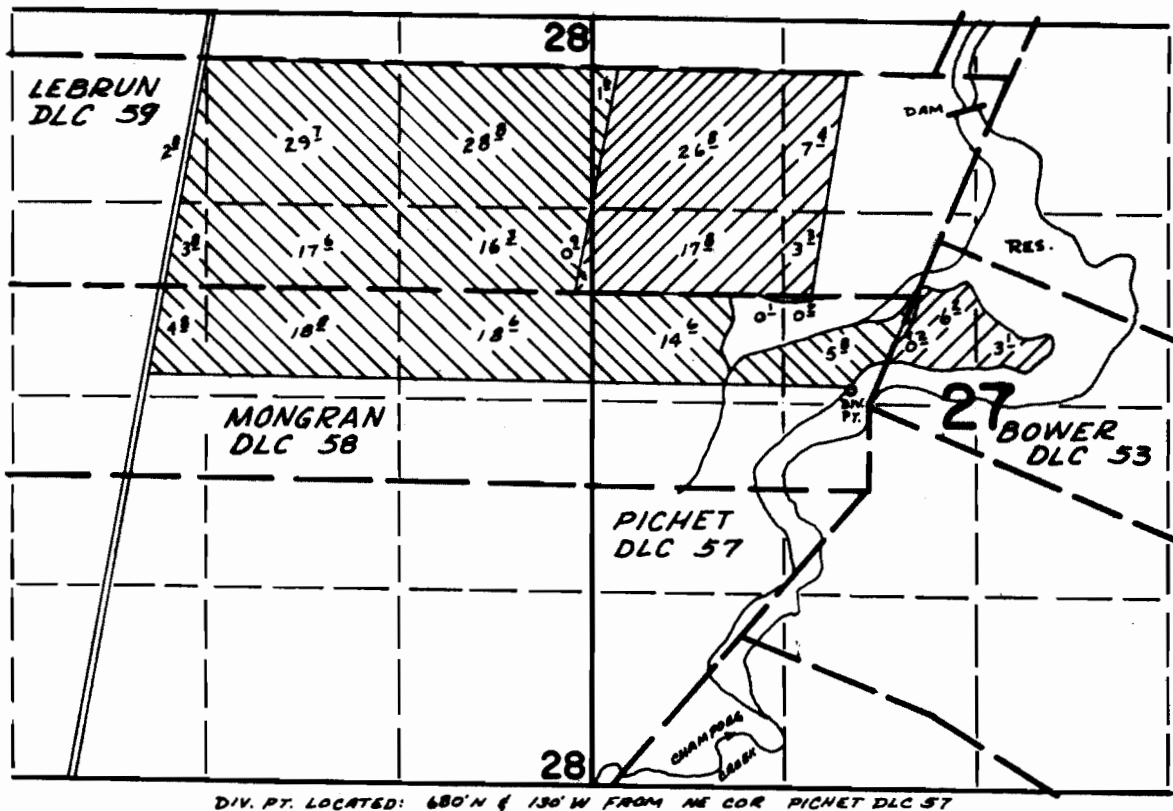

DIV. PT. LOCATED: 680' N & 130' W FROM NE COR PICHET DLC 57

FINAL PROOF SURVEY
UNDER

Application No. 44507 Permit No. 32871
IN NAME OF

ARTHUR McKAY McKAY ACRES, INC.

Surveyed Oct. 2 1972, by D. Norby