


T. 4 S., R. 2 W. W.M.

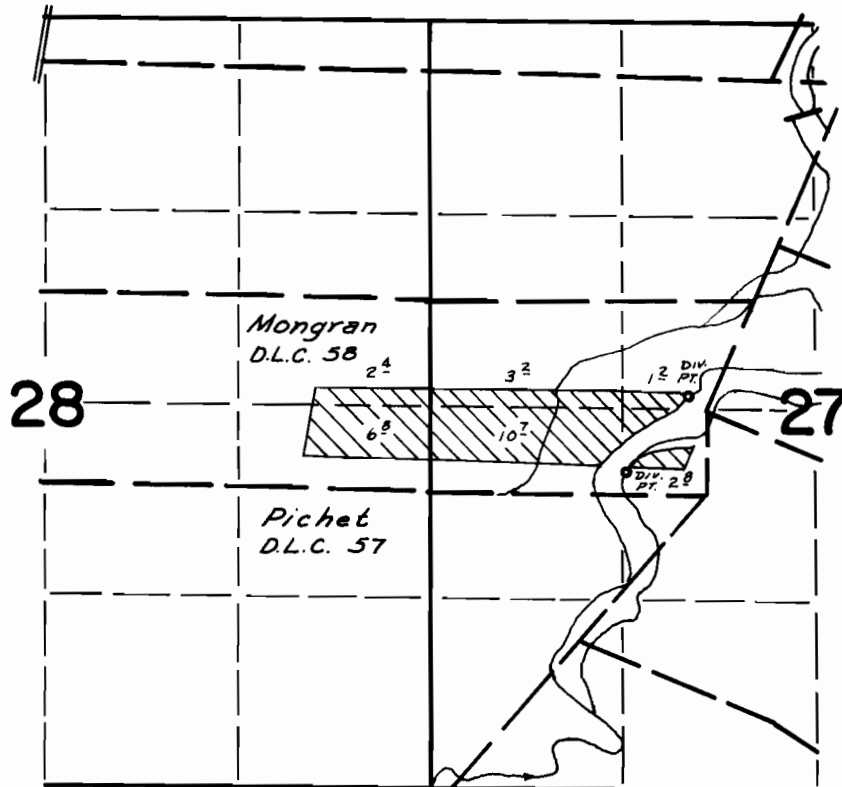

N'L'Y DIV. PT. LOCATED: 680' N & 130' W FROM NE COR PICHET DLC 57
S'L'Y DIV. PT. LOCATED: 160' N & 550' W FROM NE COR PICHET DLC 57

FINAL PROOF SURVEY UNDER

Application No. 44921 Permit No. 33490
IN NAME OF

ARTHUR MCKAY MCKAY ACRES, INC.

Surveyed Oct. 2 1972, by D. Norby