


T. 7 & 8 S. R. 1 W. W. M.

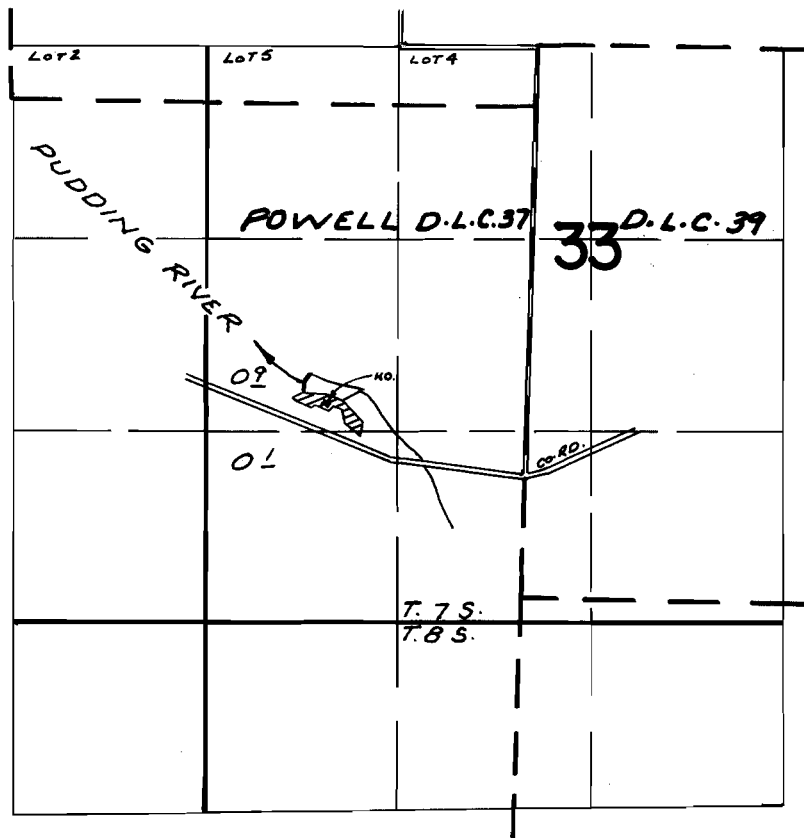

DIV. PT. LOC: 1880'S. & 1570'W. FROM N.E. COR. POWELL D.L.C. 37

FINAL PROOF SURVEY
UNDER

41786

31282

Application No. R-47793 47794 Permit No. R-5634 35126
IN NAME OF

CHRIS M. BARTRUFF

Surveyed JUNE 2, 1972, by R. MUCKEN