


T.9S.R.3W.W.M.

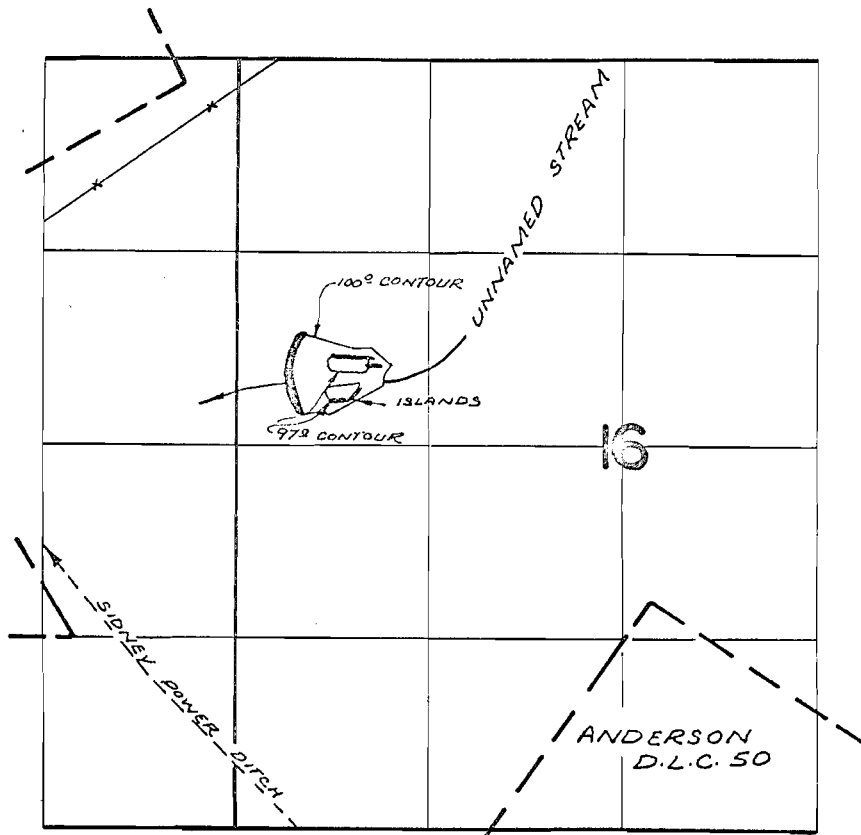

DIV. PT. LOC: 1500'X E 2460'W. FROM N. COR.
ANDERSON DLC 50

FINAL PROOF SURVEY
UNDER

R-48463 R-5670
Application No. 48346 Permit No. 35335
IN NAME OF
UNITED STATES OF AMERICA
BUREAU OF SPORT FISHERIES & WILDLIFE

Surveyed OCT. 25, 1972, by R. MUCKEN