


T.7S. R.I.E. W.M.

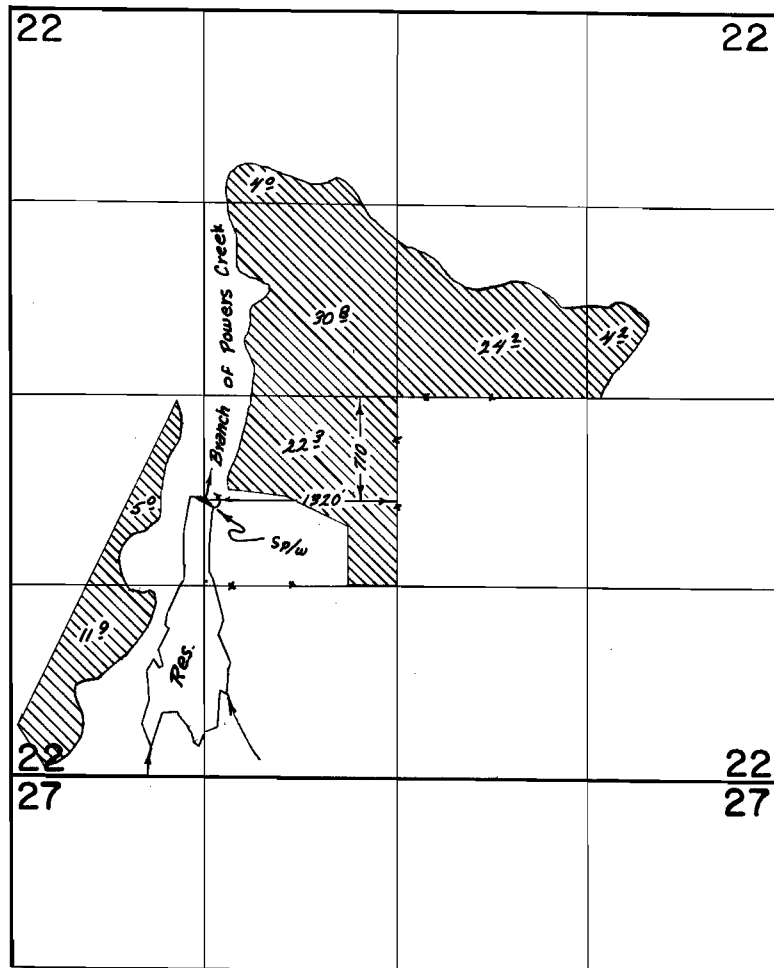

FINAL PROOF SURVEY UNDER

Application No. R-48107 48108 Permit No. R-5849 96126
IN NAME OF

ROBERT F. DeSANTIS

Surveyed June 25 1978, by R. G. Mucken