


T.6S. R.1W. W.M.

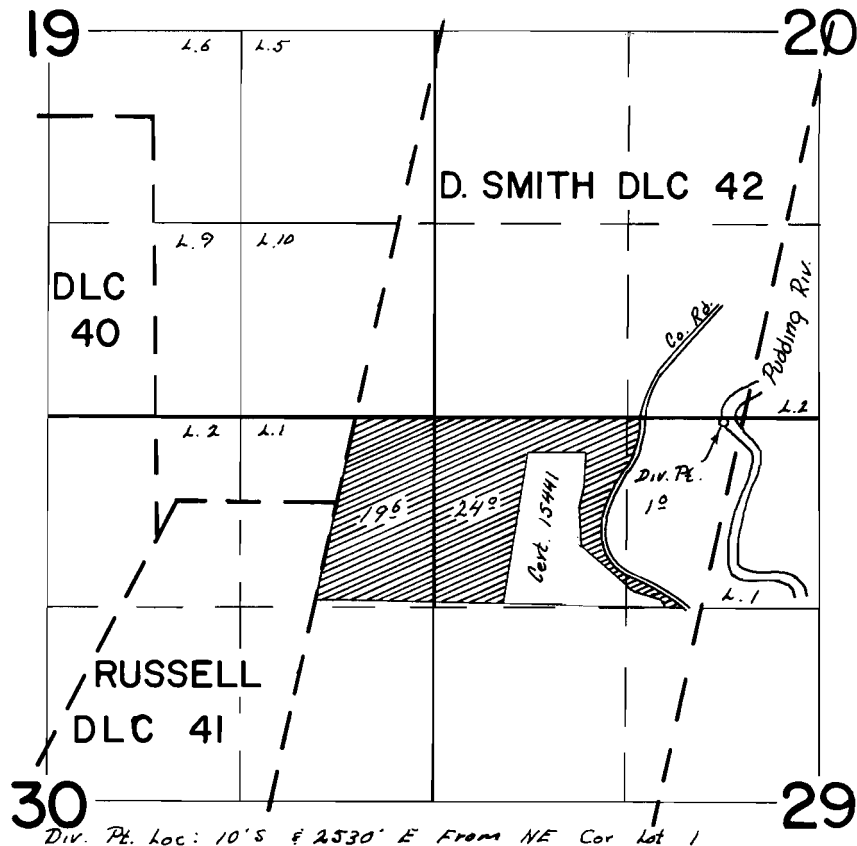

**FINAL PROOF SURVEY**  
UNDER

Application No. 41780..... Permit No. 31184  
IN NAME OF

ROBERT VACHTER

Surveyed June 13 1972, by R. G. Mucken