


T.9S.R.2E.W.M.

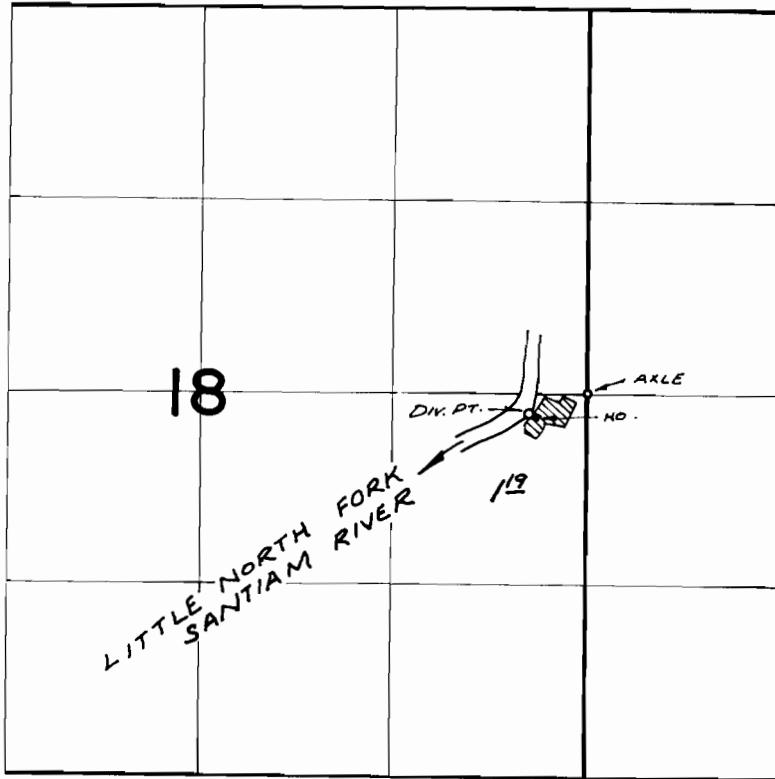

DIV. PT. LOC: 130' S. & 400' W. FROM E $\frac{1}{4}$ COR. SEC. 18

FINAL PROOF SURVEY UNDER

Application No. 42557 Permit No. 31805
IN NAME OF

RODGER FUDGE, JR.

Surveyed JULY 25, 1972, by R. MUCKEN