


T.9S.R.2E.W.M.

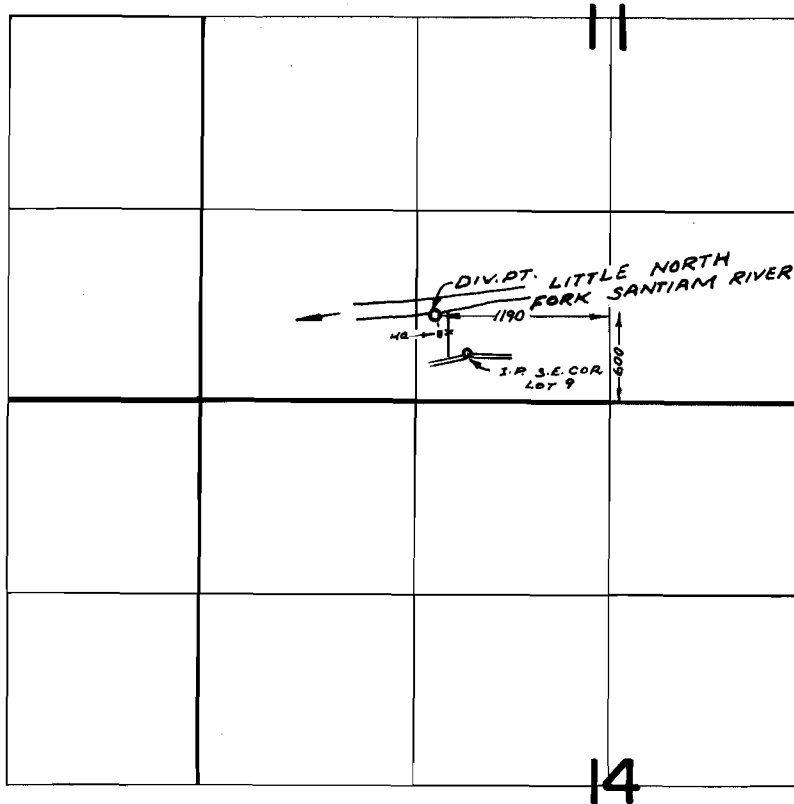

FINAL PROOF SURVEY
UNDER

Application No. 44637 Permit No. 33392
IN NAME OF

JAMES B. ELLINGSON

Surveyed July 26, 1972, by R. MUCKEN