


T.5S. R.1W. W.M.

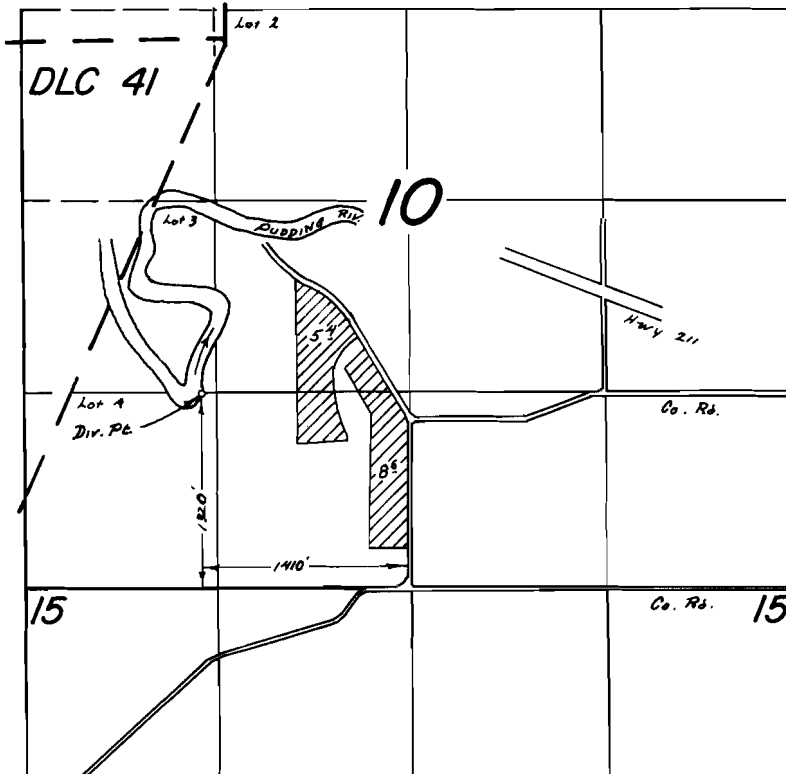

FINAL PROOF SURVEY
UNDER

Application No. 45153 Permit No. 33737
IN NAME OF

GLENN T. SEELY

Surveyed April 27 1973, by R.G. Muckert