


T.5&6S. R.IW. W.M.

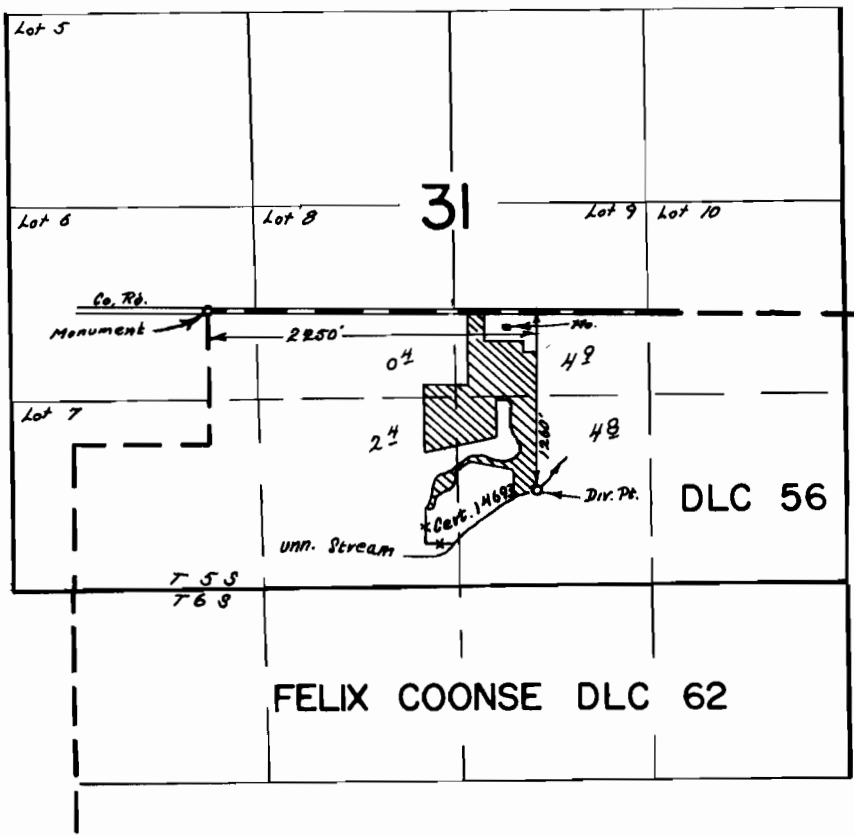

FINAL PROOF SURVEY
UNDER

Application No. 45227 Permit No. 33781
IN NAME OF

ANTON M. ENGELHARDT

Surveyed Aug 18 1972, by Musken