


T.24S., R.6W., W.M.

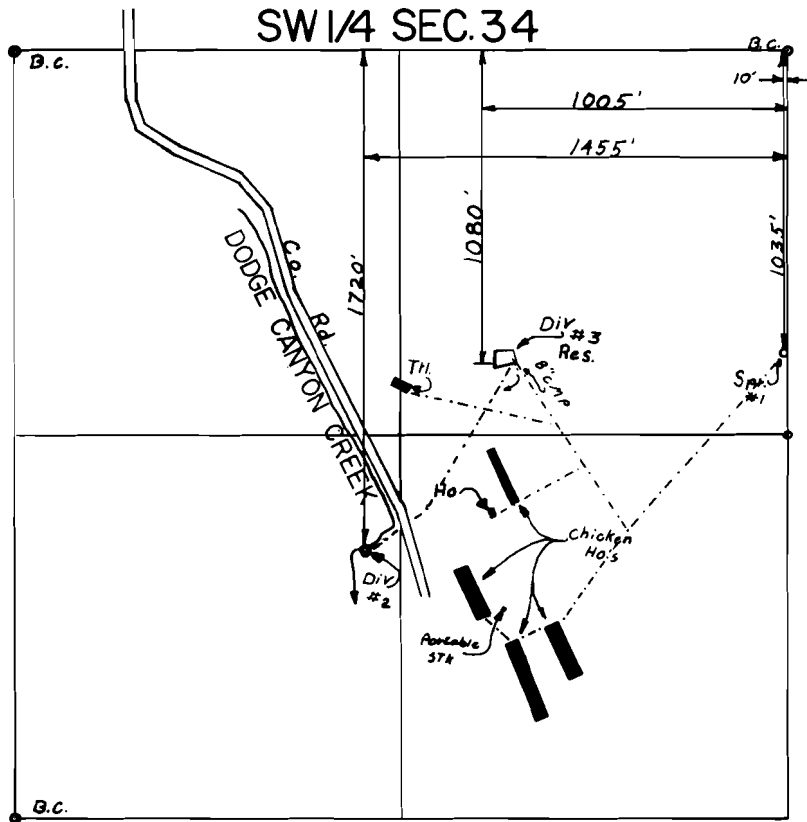

SCALE: 1"=660'

**FINAL PROOF SURVEY**  
UNDER

Application No. R-53699 53700 Permit No. R-6410 40147  
IN NAME OF

ALVIN & ETHEL JOHNSON

Surveyed NOV. 3, 1977, by D.W. SPARKS