


T.6S. R.1&2W. W.M.

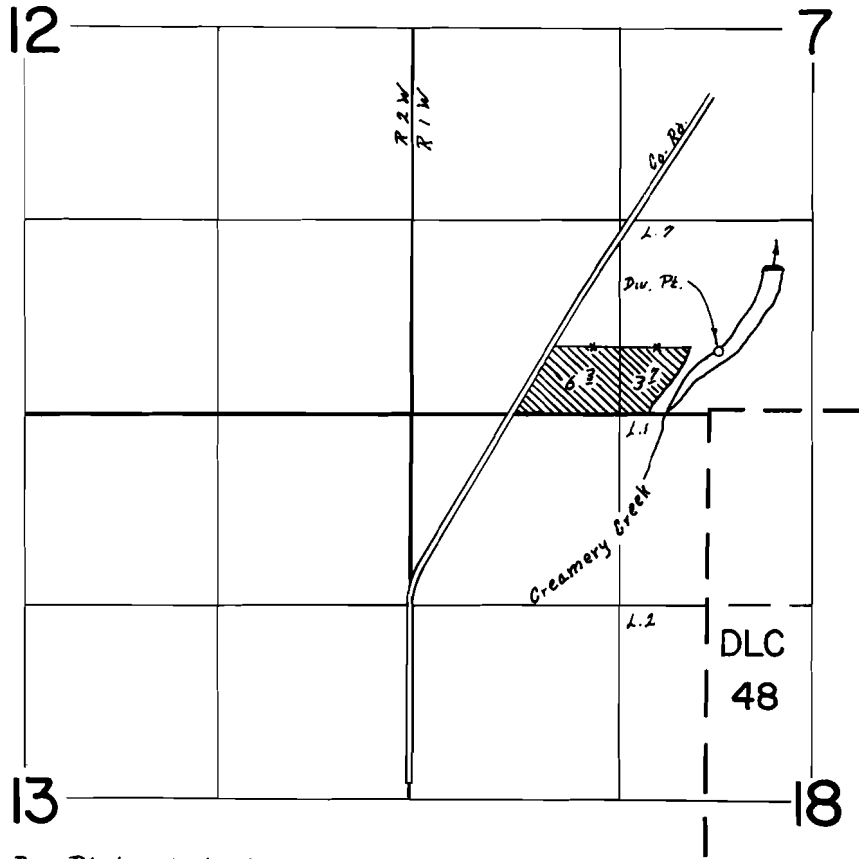

Div. Pt. Loc: 430' N & 210' E From SW Cor. Sec. 7

FINAL PROOF SURVEY
UNDER

Application No. 47257 Permit No. 35797
IN NAME OF

HOWARD H. & MILDRED P. READ

Surveyed June 16, 1922, by R. G. Mucken