


T. 1 S. R. 4 E. W.M.

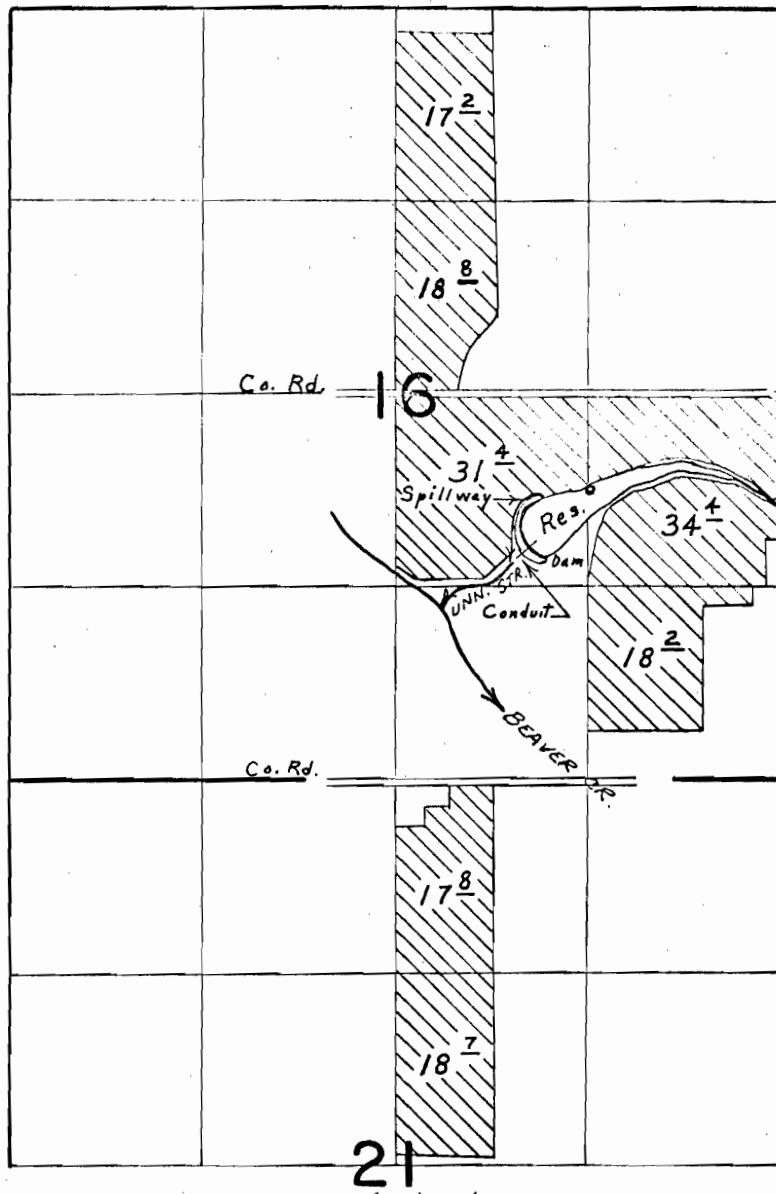

Div. Pt. located 1050' S. & 920' E. from Center Sec. 16

FINAL PROOF SURVEY UNDER

R-42755 R-4859
Application No. 43439 Permit No. 31953
IN NAME OF

WILLIAM H. SESTER

Surveyed May 10, 1973, by L. E. Gould