


T.1 N. R.39 E. W.M.

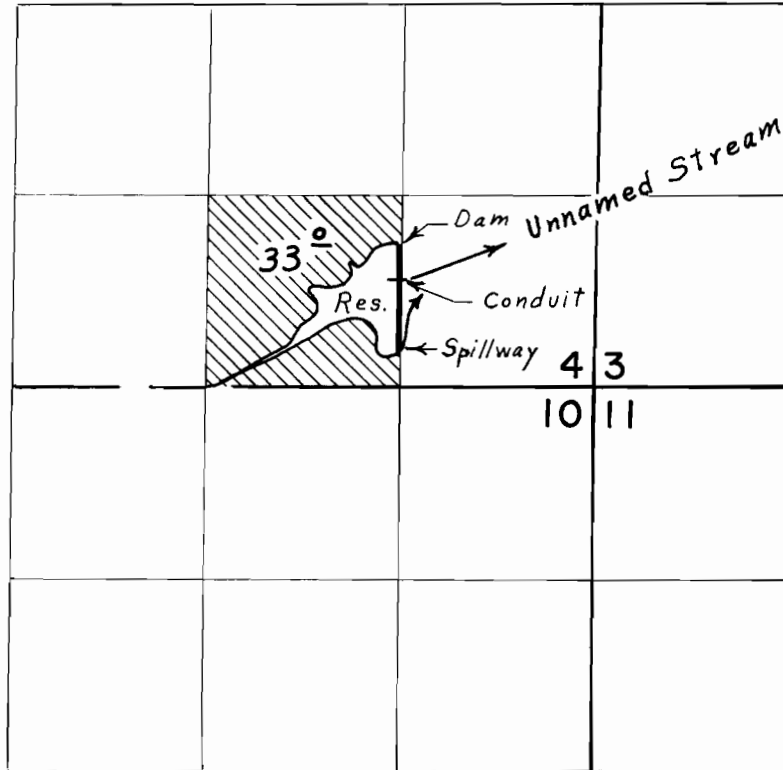

Div. Pt. located 730' N. & 1330' W. from S.E. Cor. Sec. 4

FINAL PROOF SURVEY
UNDER

R-45218 R-5297
Application No. 44831 Permit No. 33528
IN NAME OF

GEORGE R. OR BETTY J. COLKITT

Surveyed Aug. 1, 1972, by L. E. Gould