


T.485N,R.42E,W.M.

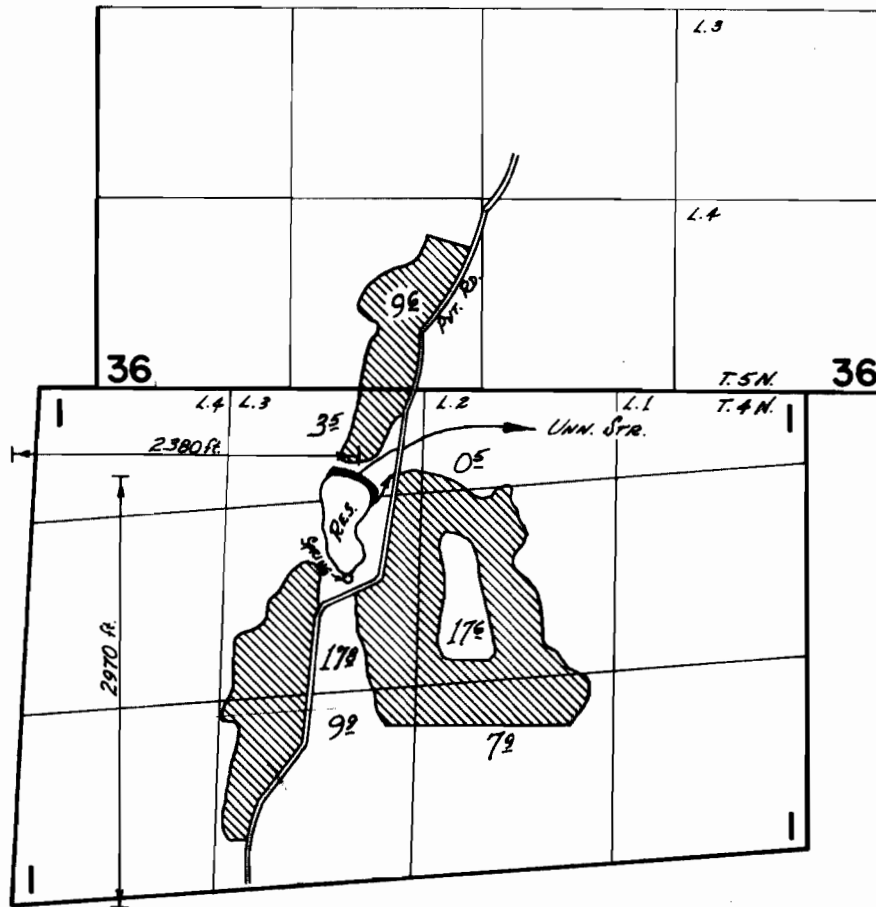

FINAL PROOF SURVEY
UNDER

R-45986 R-5401
Application No. 45730 Permit No. 34058
IN NAME OF

JAMES E. HENDERSON

Surveyed Aug. 15 1973, by D. Noesby