T.48.5N., R.42E., W.M.

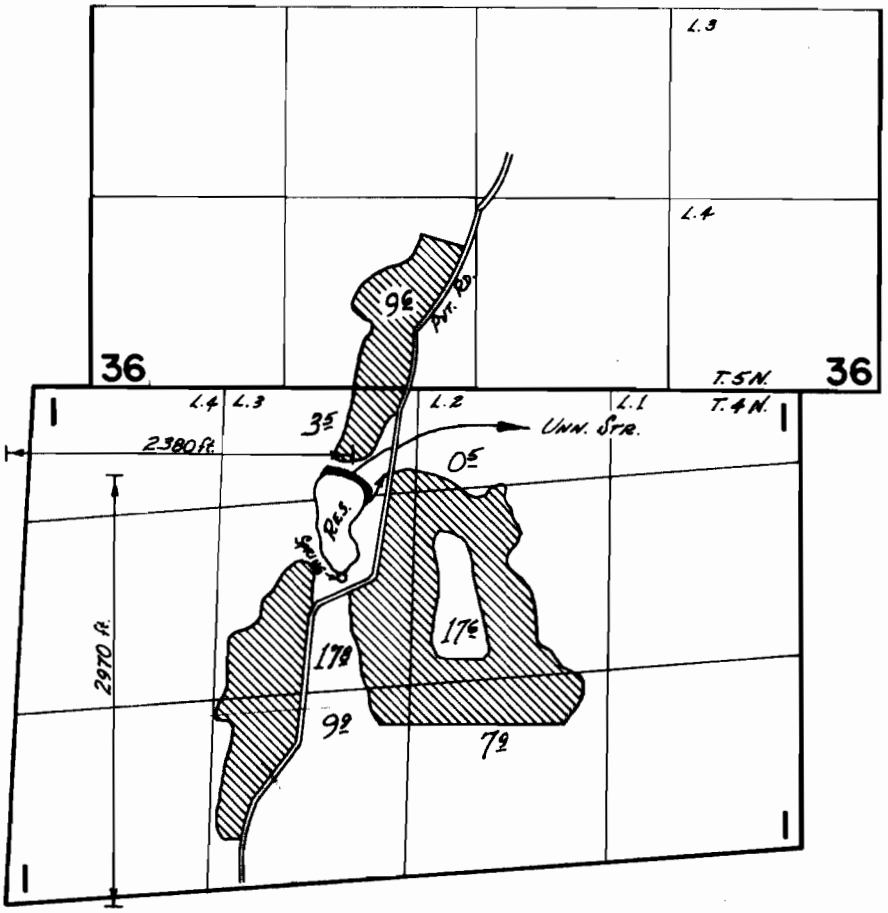

FINAL PROOF SURVEY

UNDER

Application No. R-45986 45730 Permit No. R-5401 34058

IN NAME OF

JAMES E. HENDERSON

Surveyed Aug. 15 19 73, by D. Norby

BPA-SMM-49