


T.2N.,R.4W.,W.M.

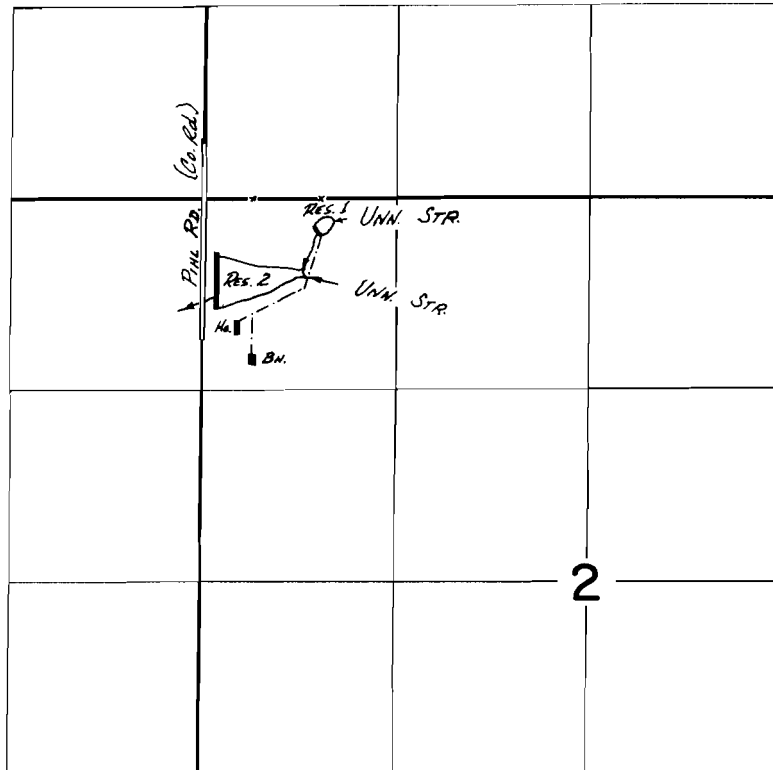

Div. Pts. loc.: #1-240' S. & 780' E.; #2-670' S. & 80' E.; both from NW
cor. Sec. 2.

FINAL PROOF SURVEY
UNDER

R-40844 R-5789
Application No. 40845 Permit No. 35838
IN NAME OF
HOLLIE PIHL

Surveyed JUNE 27, 1972, by D. NORBY