


T.4S.,R.5W.,W.M.

RECEIVED
MAY 22 1974
STATE ENGINEER
SALEM, OREGON

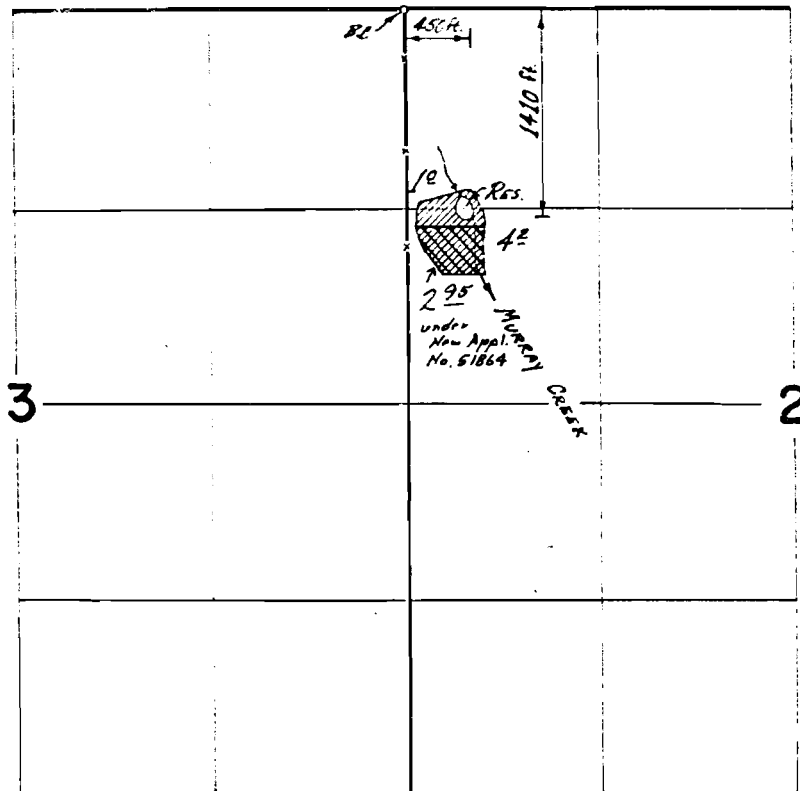

FINAL PROOF SURVEY
UNDER

R-4190 R-4695
Application No. 41911 Permit No. 31106
IN NAME OF

DONALD R. MURRAY

Surveyed MAY 11 1973, by D. Nobby

Application No. 51864
Permit No. 39043