


T.5S.,R.3W.,W.M.

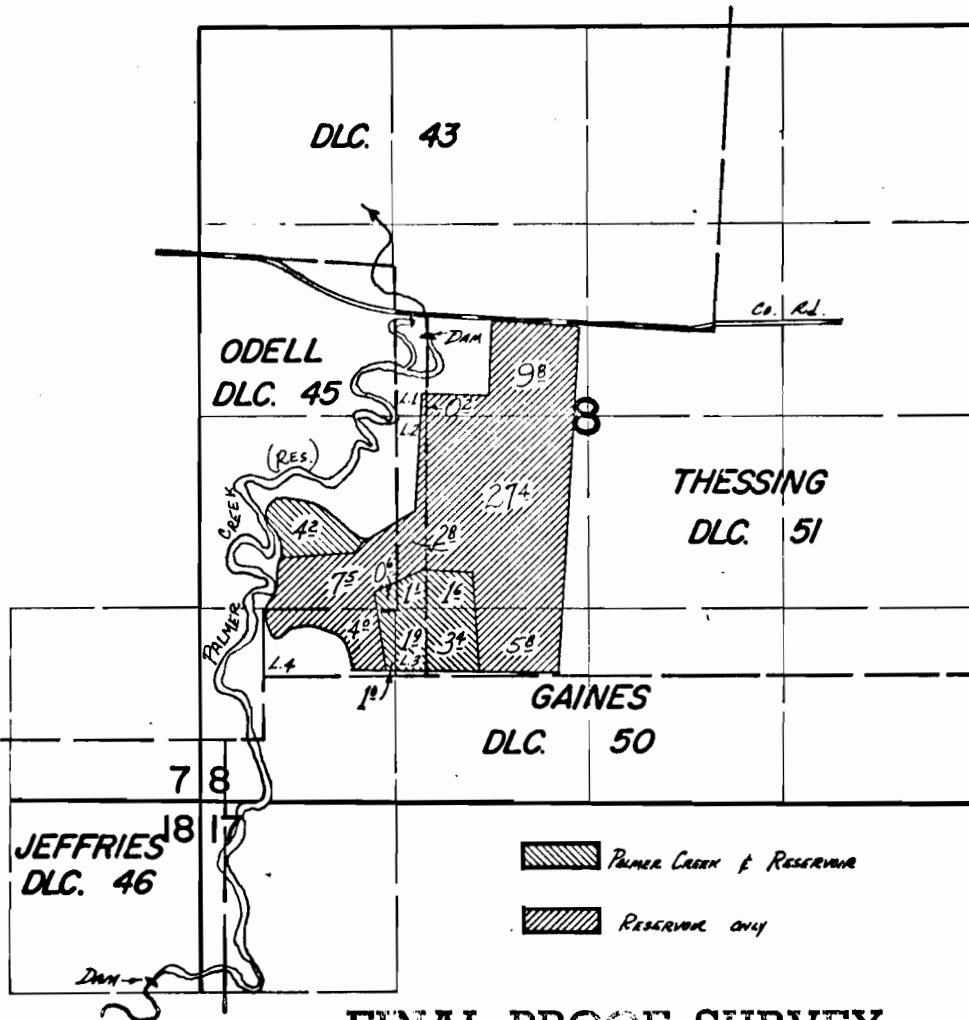

FINAL PROOF SURVEY
UNDER

R-45654 R-5602
Application No. 45655 Permit No. 34958
IN NAME OF

BARRY W. HOUSE

Surveyed MAY 18 1973, by D. NORBY