


T.5S.,R.3W.,W.M.

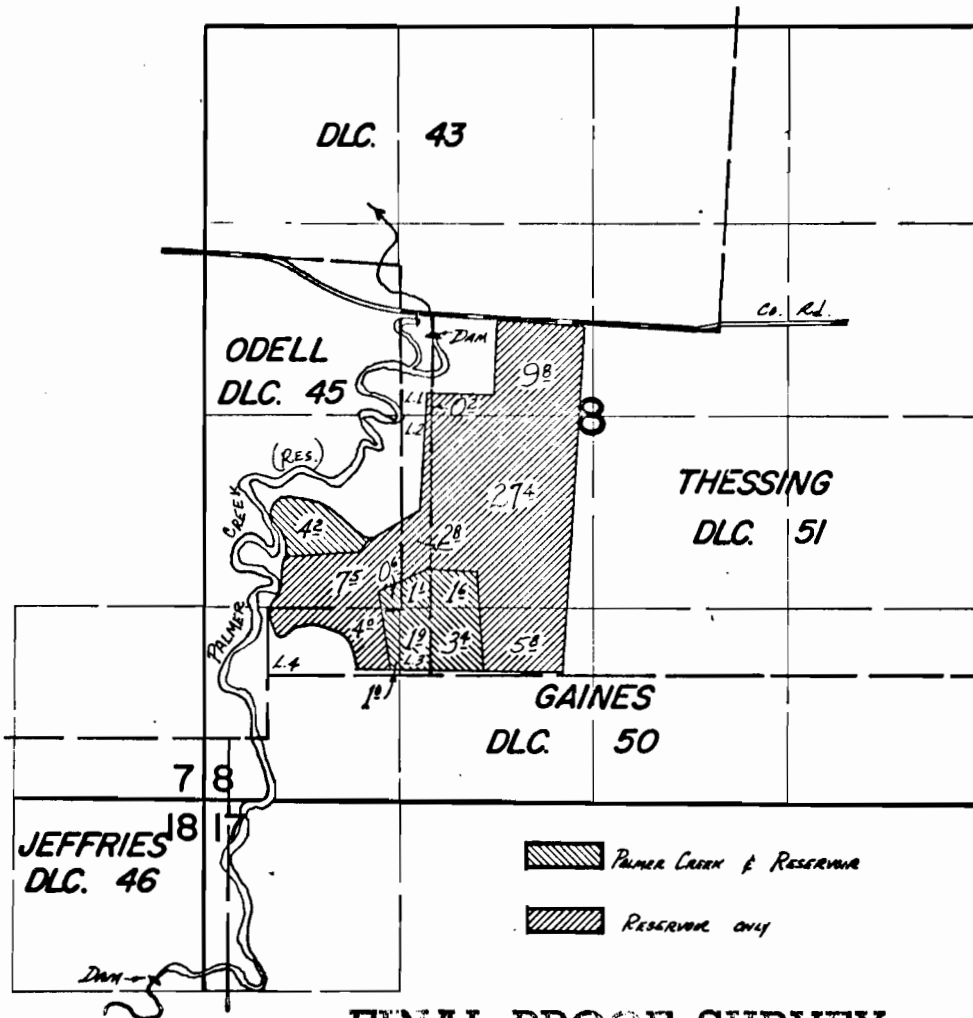

**FINAL PROOF SURVEY**  
UNDER

R-45654                      R-5602  
Application No. 45655    Permit No. 34958  
IN NAME OF

**BARRY W. HOUSE**

Surveyed May 18 1973, by D. Norby