


T.4S.,R.4W.,W.M.

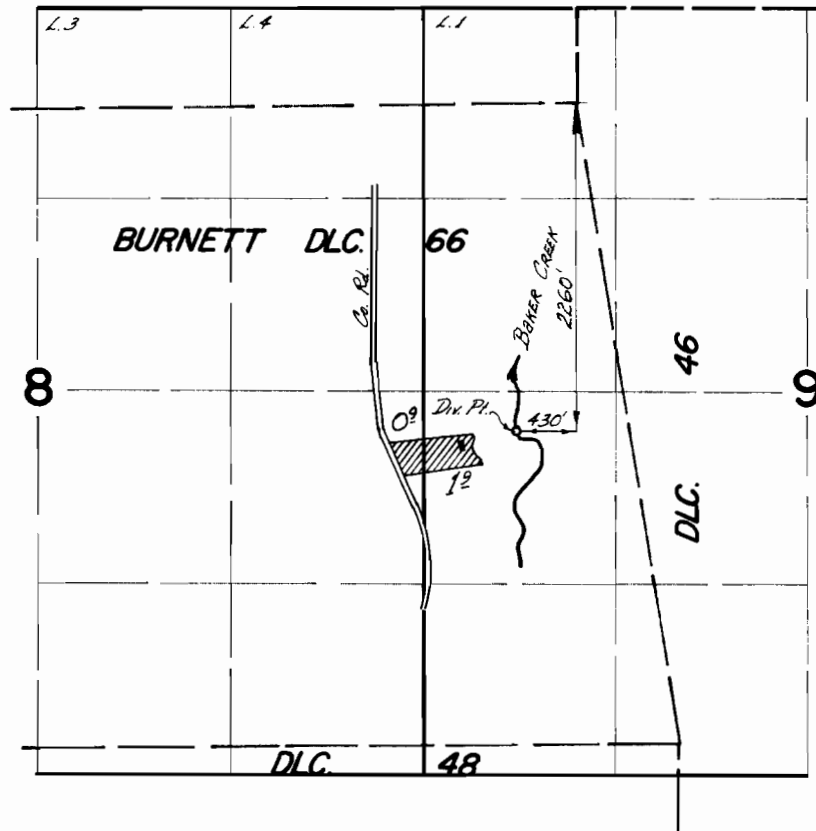

FINAL PROOF SURVEY
UNDER

Application No. 41855 Permit No. 31042
IN NAME OF

JOHN R. BROWNING

Surveyed May 15 1973, by D. NORBY