


T.5S.R.6W.W.M.

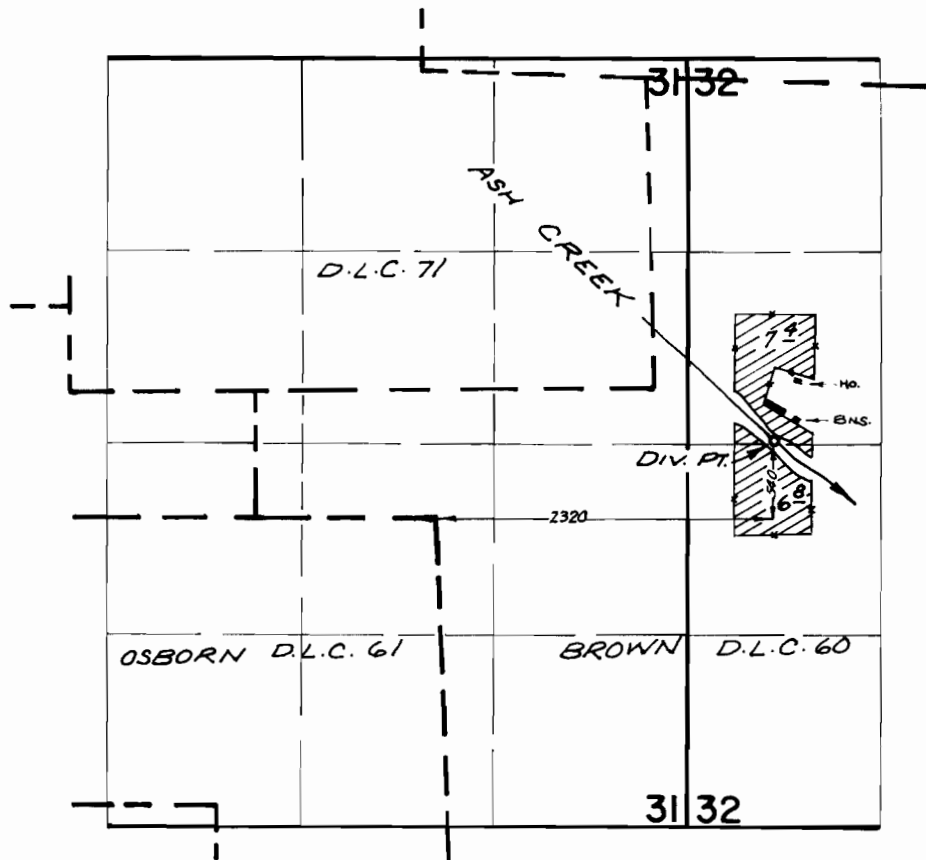

FINAL PROOF SURVEY UNDER

Application No. 41853... Permit No. 31406...
IN NAME OF

.....ROBERT P. POTTER.....

Surveyed FEB. 13, 1973, by R. MUGKEN