


T.2S.R.3W.W.M.

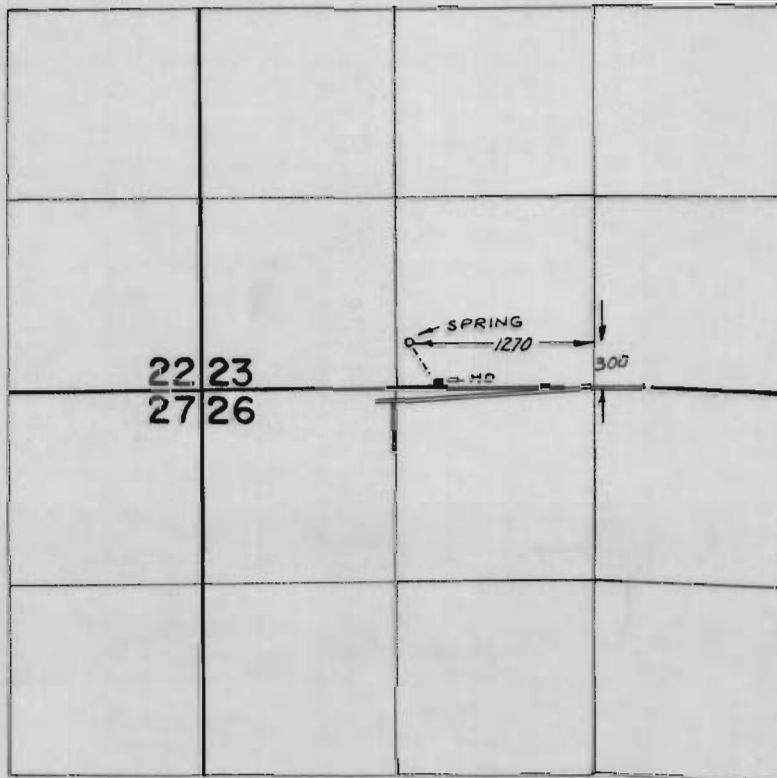

FINAL PROOF SURVEY
UNDER

Application No. 47636 Permit No. 35650
IN NAME OF

MARDSEN W. MANSON

Surveyed MAR 26 1973, by L. E. GOULD