


T.28&3S. R.2W. W.M.

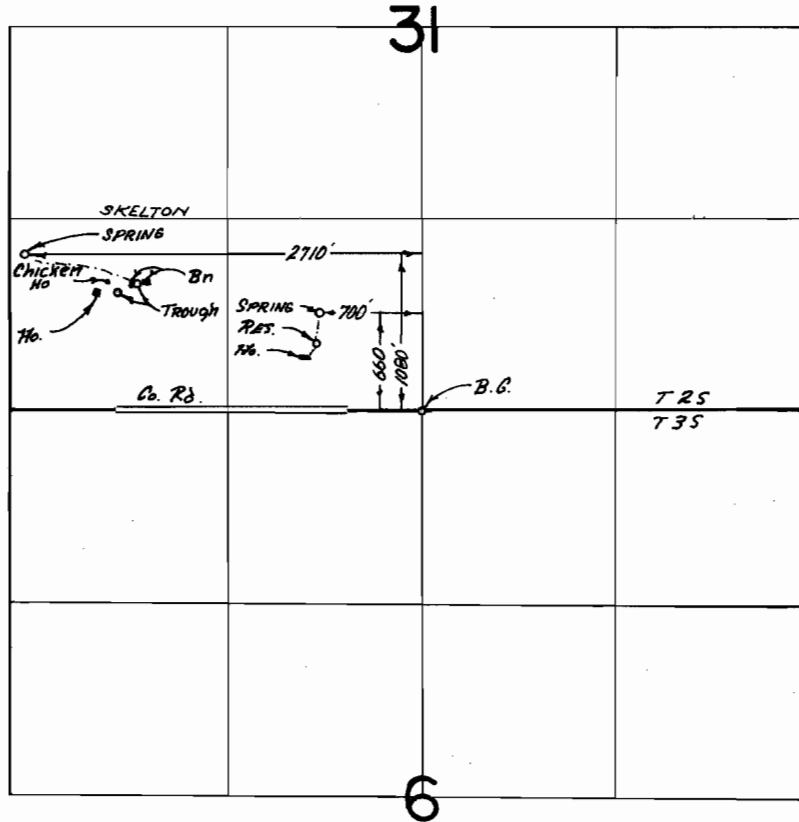

FINAL PROOF SURVEY
UNDER

Application No. 47960 Permit No. 35954

IN NAME OF

JOHN KROO

Surveyed SEPT. 17 1973, by L. E. BOULD