T. 5 S.R.4W.W.M.

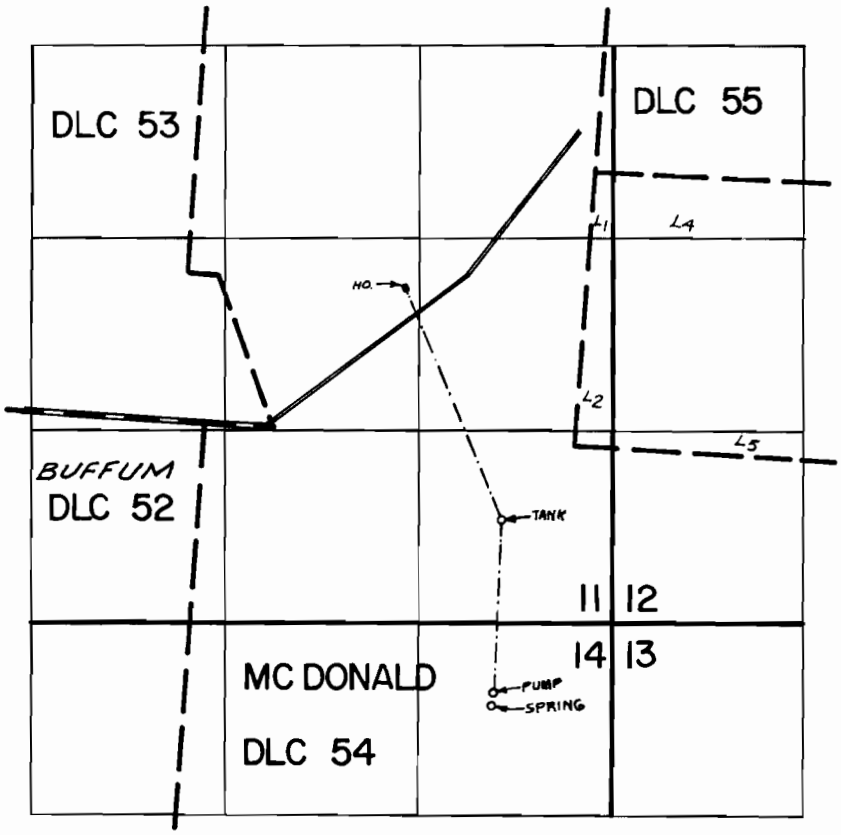

SPRING LOC: 1990'S & 1970'E FROM N.E COR. BUFFUM DLC 52

FINAL PROOF SURVEY
UNDER

Application No. 49775 Permit No. 36098
IN NAME OF

BEN L. PARTCH

Surveyed MAY 30 19 73, by R.G. MUCKEN

DFO-ILL-163 P.C.