


T.10S., R.4W., W.M.

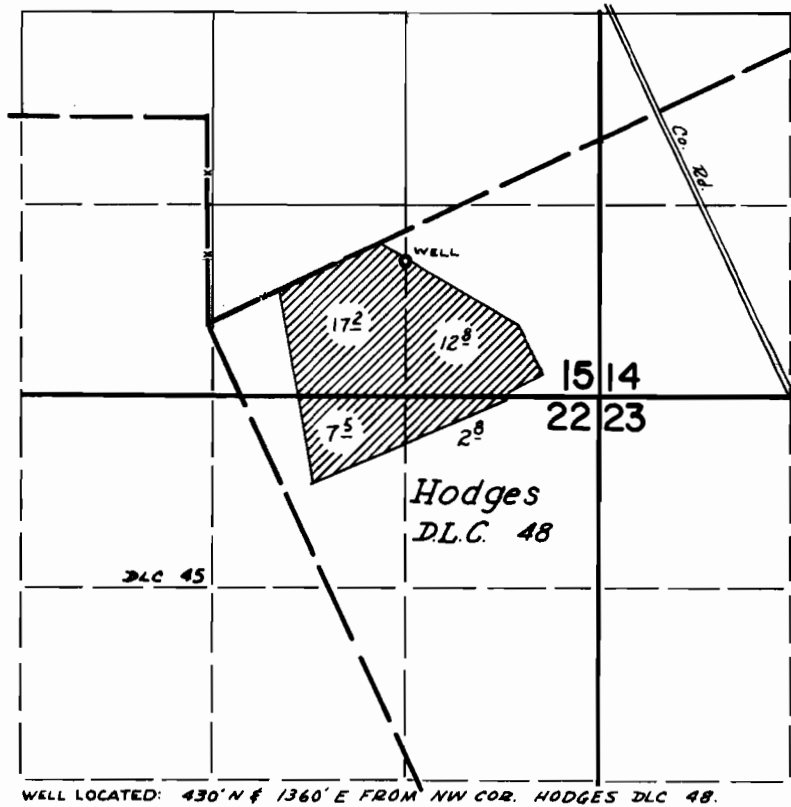

FINAL PROOF SURVEY
UNDER

Application No. G-4533 Permit No. G-4268
IN NAME OF

RUSSELL UNDERWOOD

Surveyed Aug. 16 1972, by D. Norby