


T.10S., R.3W., W.M.

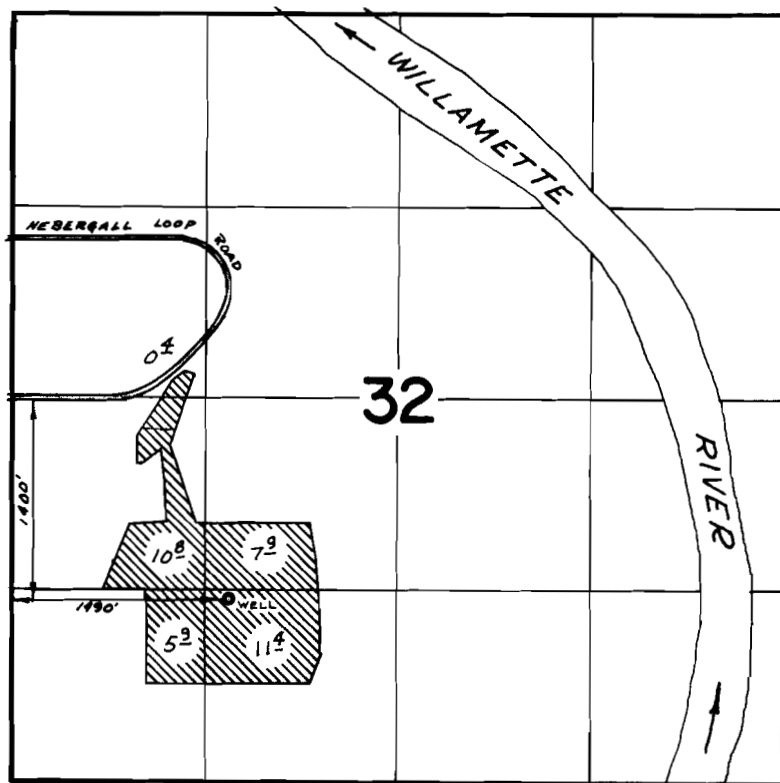

**FINAL PROOF SURVEY**  
UNDER

Application No. G-5076 Permit No. G-4792  
IN NAME OF

BERTHA KENAGY

Surveyed Aug 15 1972, by D. Norby