


T.10S., R.4W., W.M.

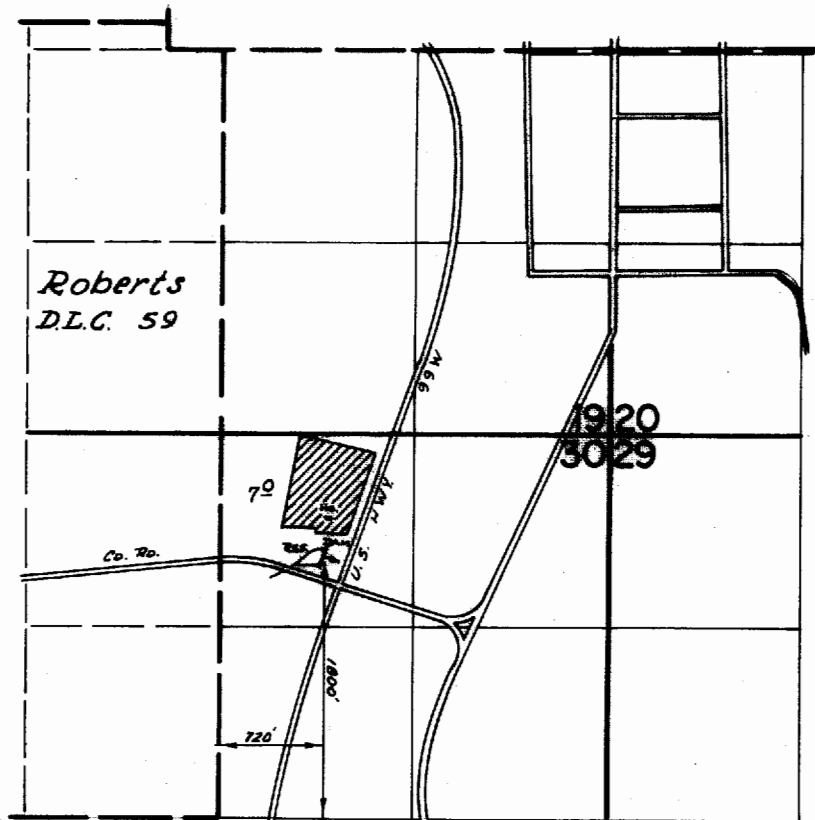

FINAL PROOF SURVEY UNDER

47109 35274
Application No. R-47146 Permit No. R-5659
IN NAME OF

ROBERT J SHINE

Surveyed Aug. 17 1972, by D. Norby