


# T.10S., R.4W., W.M.

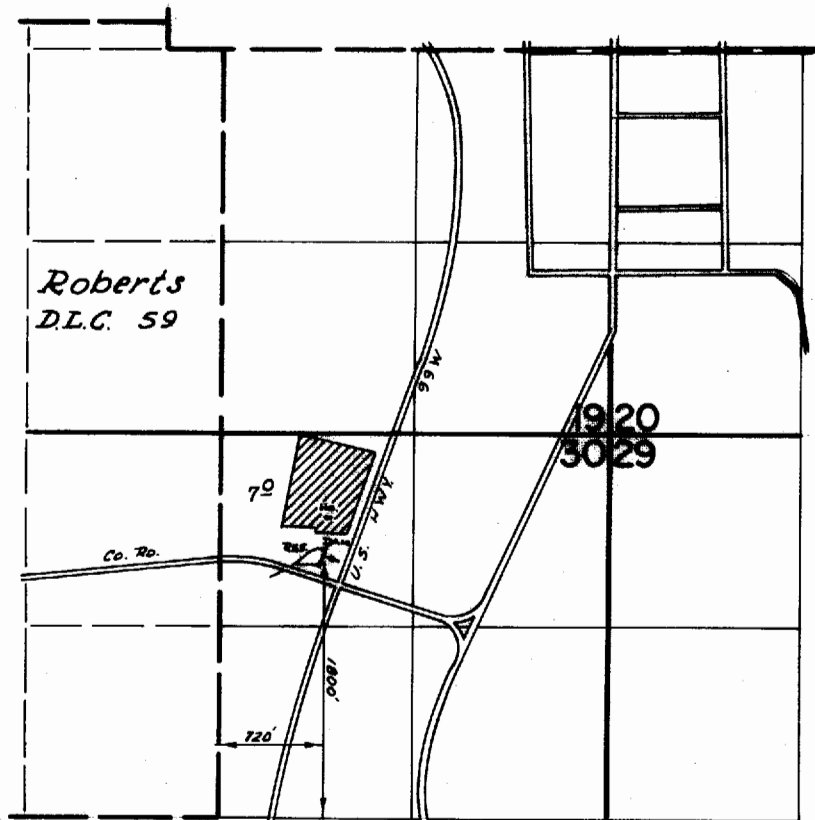

## FINAL PROOF SURVEY UNDER

47109                      35274  
Application No. R-47146 Permit No. R-5659  
IN NAME OF

ROBERT J SHINE

Surveyed Aug. 17 1972, by D. Norby