


T.10S., R.3W., W.M.

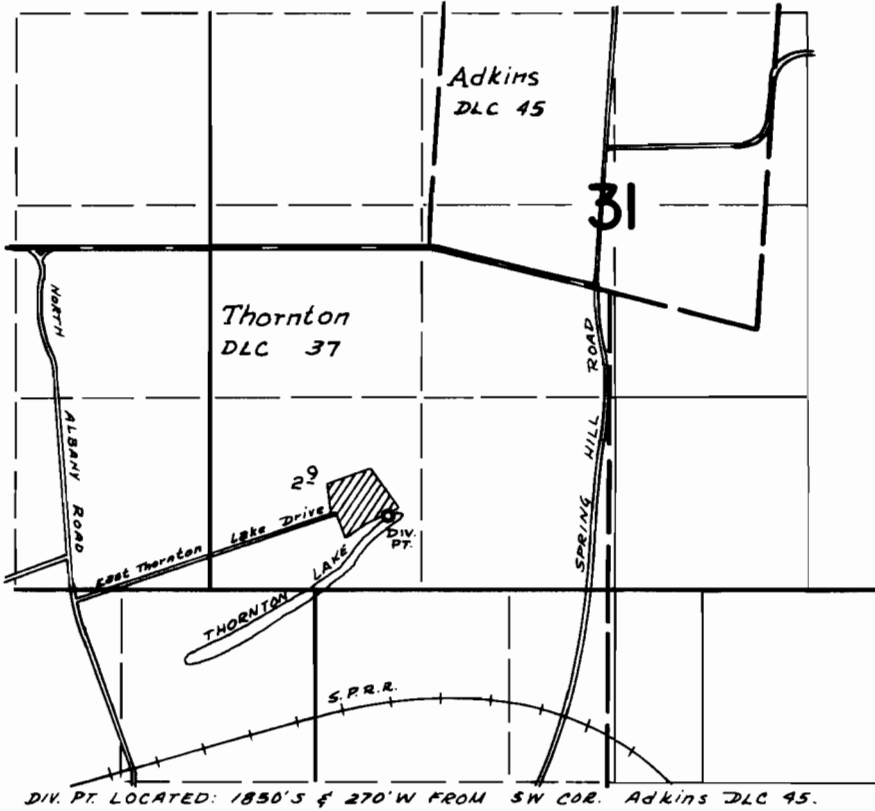

**FINAL PROOF SURVEY**  
UNDER

Application No. 46067..... Permit No. 34006.....  
IN NAME OF

H. DAN & MARSHA S. MOORE

Surveyed Aug. 16 1972, by D. Norby