


T. 30 S. R. 10 W. W. M.

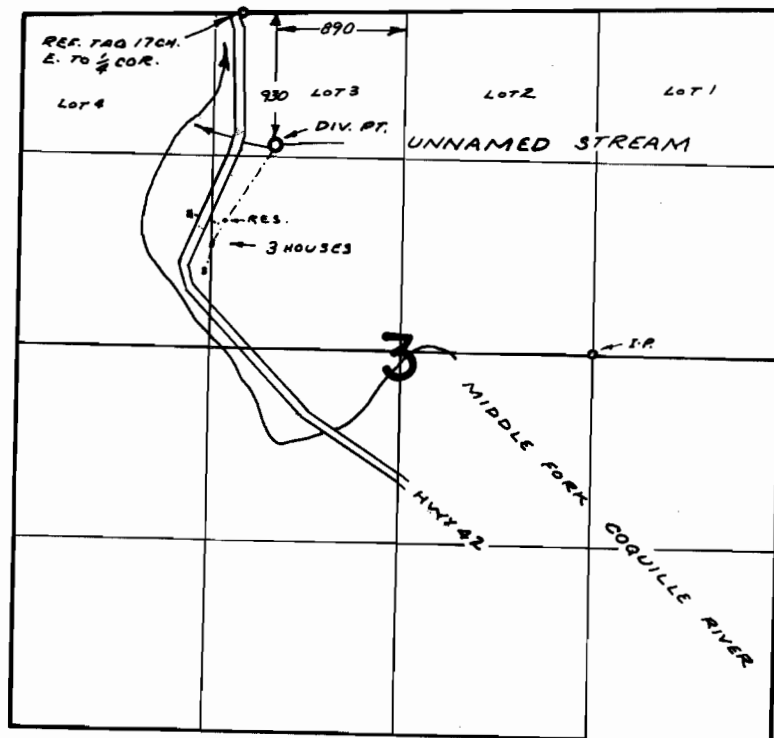

FINAL PROOF SURVEY
UNDER

Application No. 40573 Permit No. 30231
IN NAME OF

KENNETH R. CLARK

Surveyed JULY 14, 1972, by R. MUCKEN