


T.24&25S., R.5W., W.M.

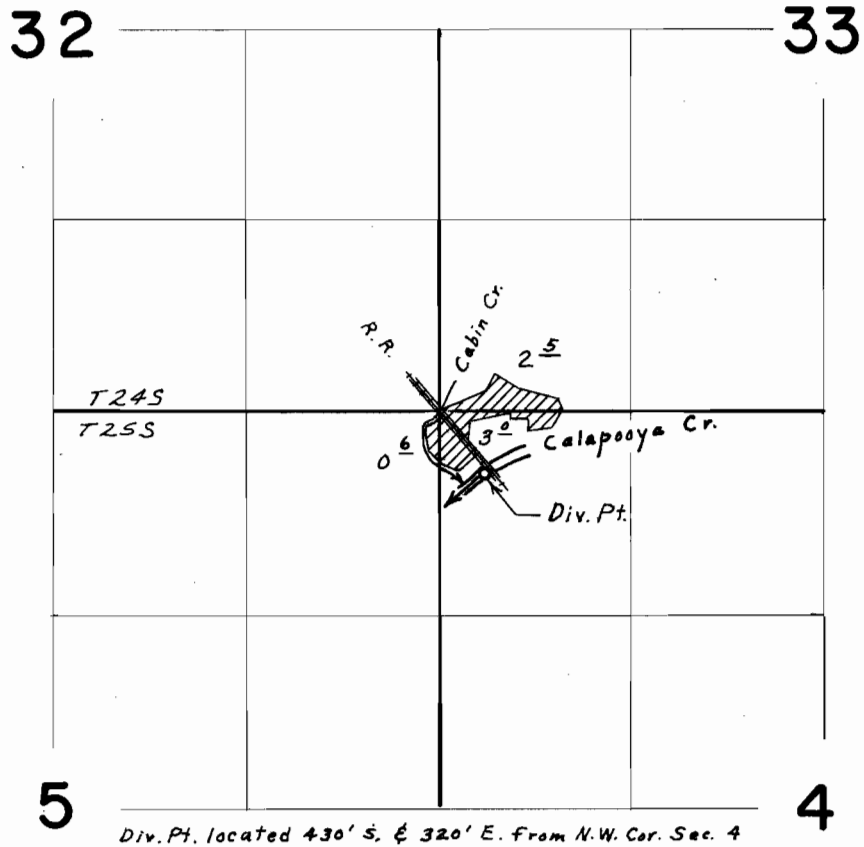

FINAL PROOF SURVEY
UNDER

Application No. 42990 Permit No. 32120
IN NAME OF

HERMAN J. & IZA B. MATHIS

Surveyed May 10, 1972, by L. E. Gould