


# T.28S., R.8 W., W.M.

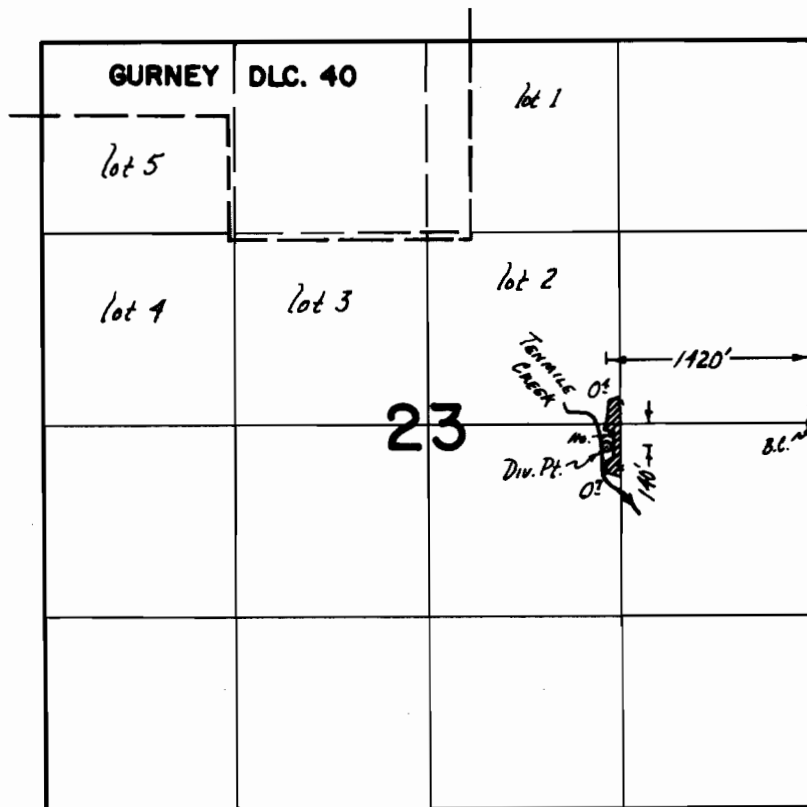

## FINAL PROOF SURVEY UNDER

Application No. 43357 Permit No. 32405  
IN NAME OF

*SUN STUDS INC.*

Surveyed 12 MAY 1972, by D. NORBY