


33638

T.1S. - R.10E. - W.M.

T.1S. - R.9E. W.M.

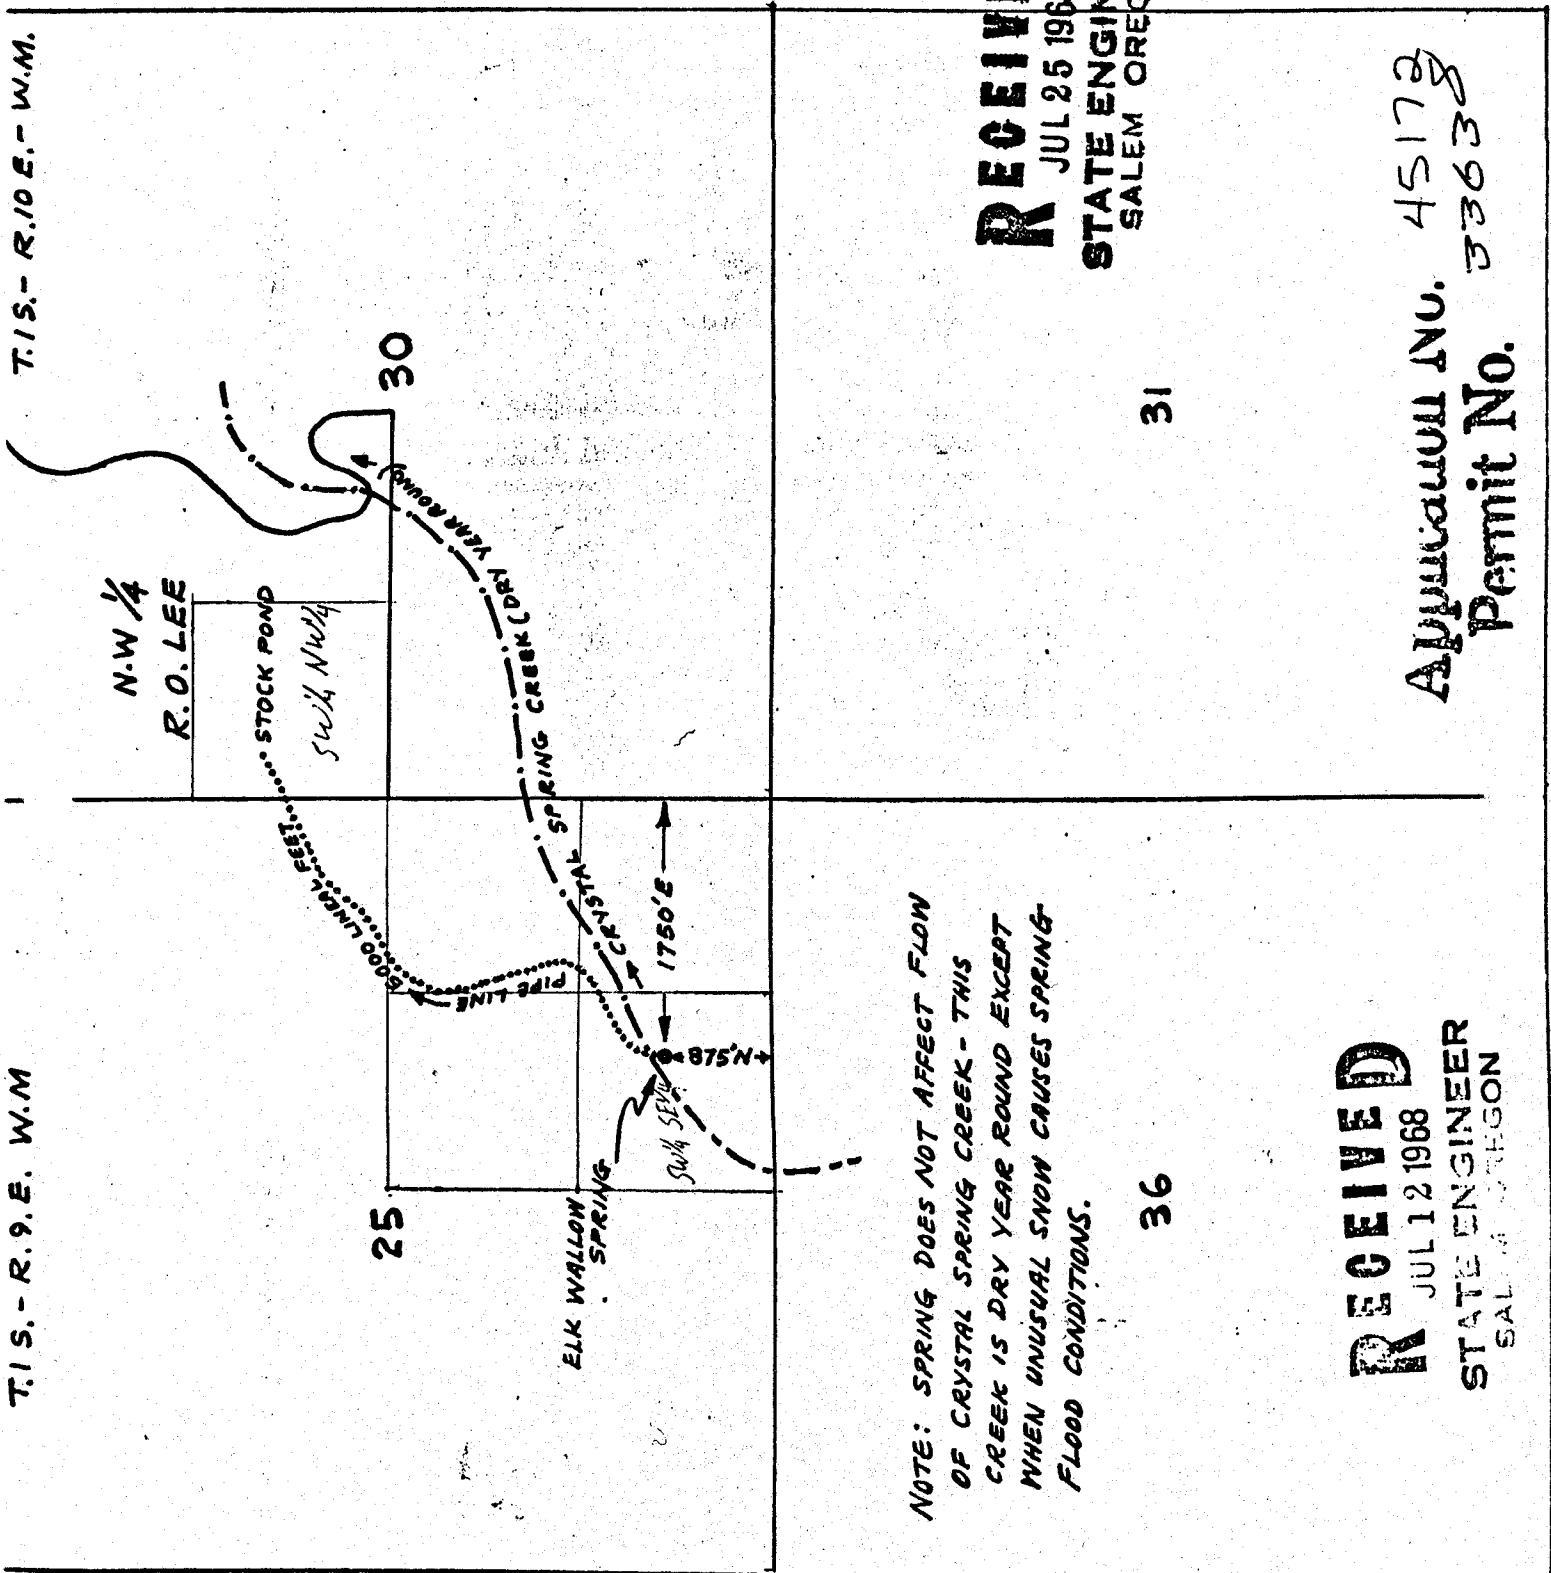

NOTE: SPRING DOES NOT AFFECT FLOW  
 OF CRYSTAL SPRING CREEK - THIS  
 CREEK IS DRY YEAR ROUND EXCEPT  
 WHEN UNUSUAL SNOW CAUSES SPRING  
 FLOOD CONDITIONS.

36

**RECEIVED**  
 JUL 25 1968  
 STATE ENGINEER  
 SALEM OREGON

31

**RECEIVED**  
 JUL 12 1968  
 STATE ENGINEER  
 SALEM OREGON

Applicatoin No. 45172  
 Permit No. 33638

R.O. LEE 7/11/68