


T.33S.R.6W.W.M.

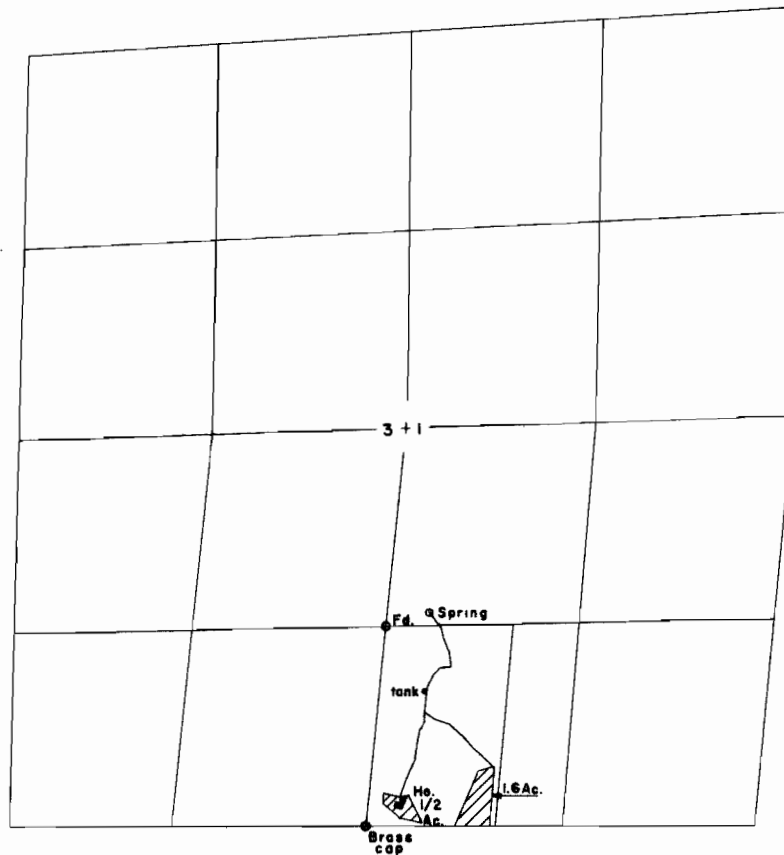

Spring is located 90' N. & 290' E. from the N.W. COR. Of the S.W. 1/4 S.E. 1/4

FINAL PROOF SURVEY
UNDER

Application No. 48342 Permit No. 36299
IN NAME OF

HERBERT B. DUNHAM

Surveyed April 10, 1974, by R.B. STEIMER.