


G-3443

40185

# T.38S., R.11E., W.M.

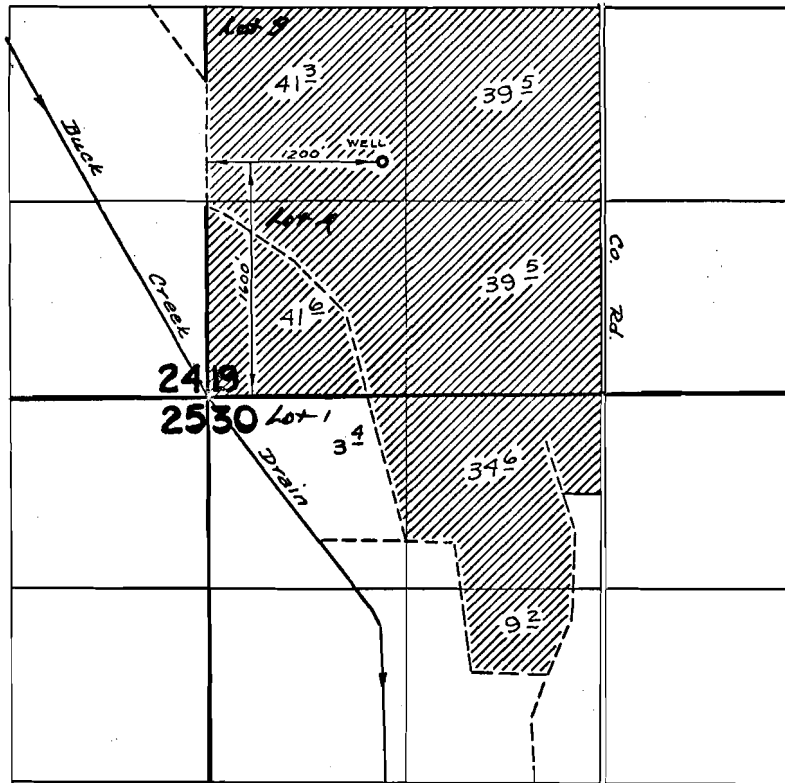

Buck Crk : Yonna Valley wells

## FINAL PROOF SURVEY UNDER

Application No. G-3667 Permit No. G-3443  
IN NAME OF

HASKINS And COMPANY, Inc.

Surveyed Oct. 18 1972, by D. Norby