


G-4164  
40186

# T. 37S., R. 14E., W.M.

High Horse Ck. Wells

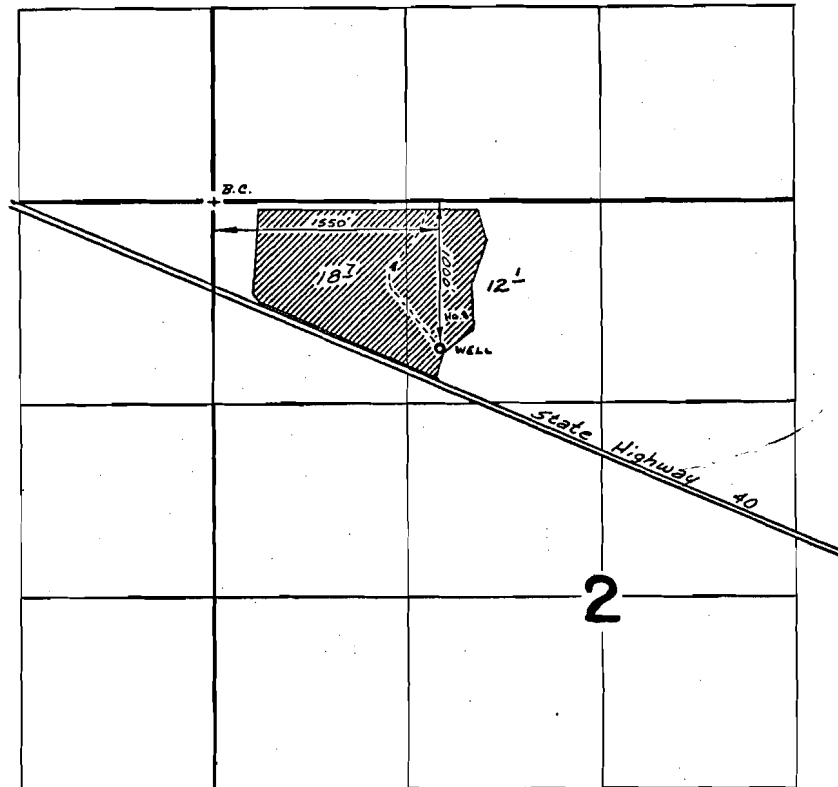

## FINAL PROOF SURVEY UNDER

Application No. G-4418 Permit No. G-4164  
IN NAME OF

JEROLD D. and GWENDLYN D. DILLAVOU

Surveyed Oct 12 1972, by D. Norby