


G-4309
40187

T.37S., R.14E., W.M.

S. Jk. Sprague R. wells

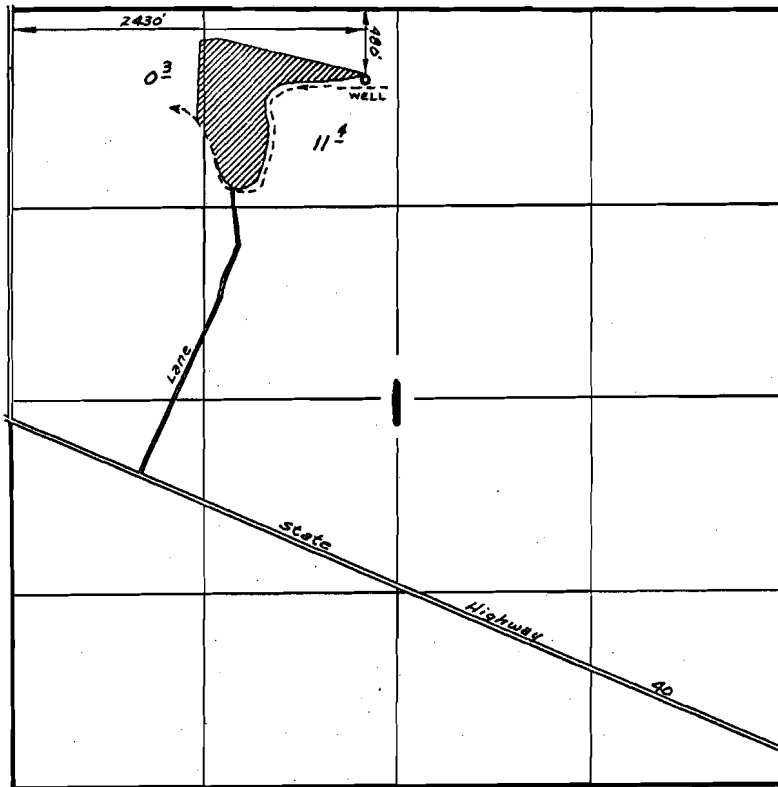

FINAL PROOF SURVEY UNDER

Application No. G-4579 Permit No. G-4309
IN NAME OF

EVERETT M. & PAULINE S. BELL

Surveyed Oct 12 1972, by D. Norby