


T. 40 S. R. 20 E. W.M.

6 2597
40195

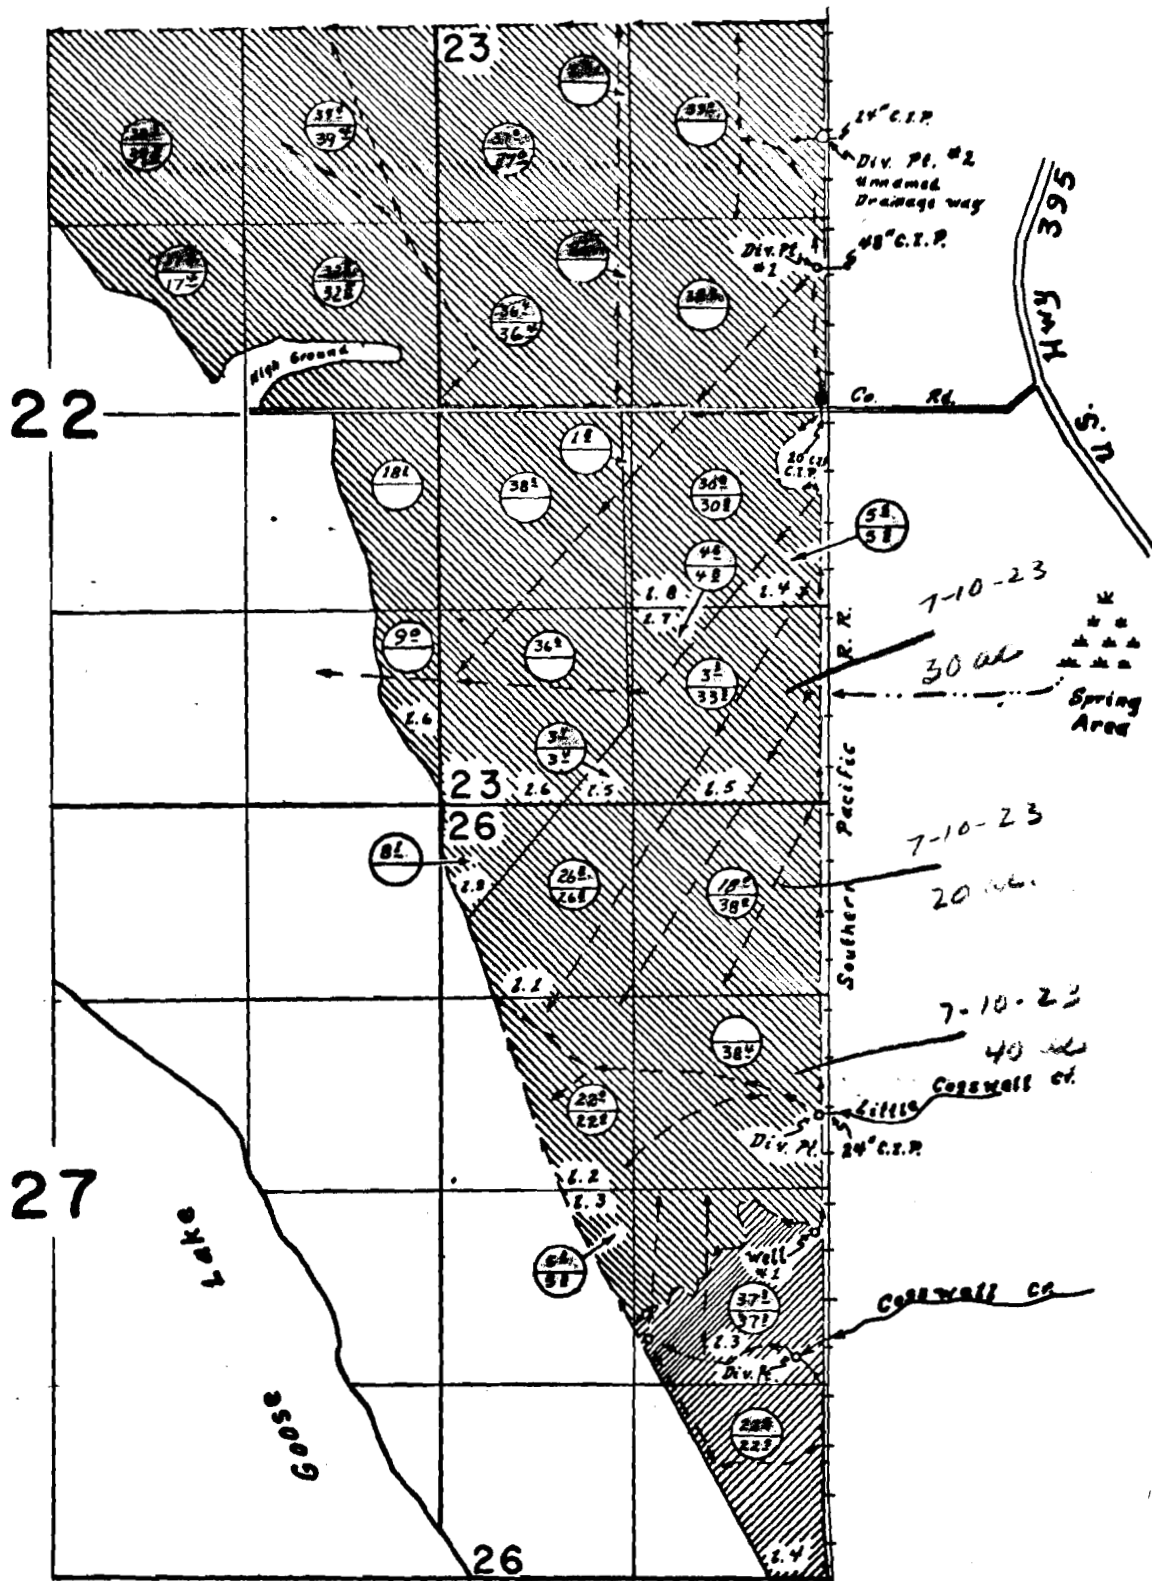

Div. Pl. from Cognawall Cr. loc. 1500' N. & 220' W. from S. & Cor. Sec. 26
 Div. Pl. #1 loc. 970' N. & 40' W. } From Center of Sec. 23
 Div. Pl. #2 loc. 1870' N. & 40' W. }
 Well #1 loc. 2930' S. & 60' W. from S. & Cor. Sec. 25

FINAL PROOF SURVEY UNDER

G-2717
27339

See

P 2549
G-2587
23661

Primary
Supplemental

Application No. 39157 Permit No. 29344
IN NAME OF

Neal Elliott

Surveyed 20 Sept. 1972 by L.E. Gould