


P 27314
40198

T. 38 S. R. 18 E. W.M.

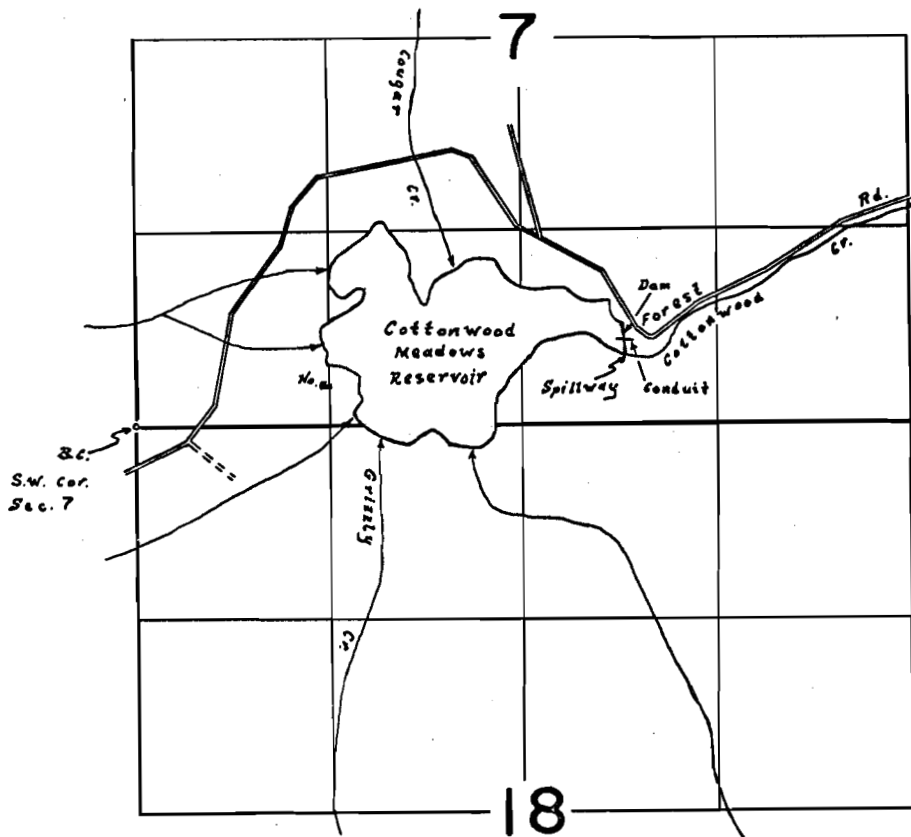

Div. Pl. Sec. 570' N. & 3330' E. from S.W. Cor. Sec. 7

FINAL PROOF SURVEY
UNDER

R-34139

R-2610

Application No. 34140..... Permit No. 27314
IN NAME OF

Oregon State Game Commission

Surveyed 21 Sept. 1972, by L. E. Gould

38-18V

Photo CH2-SKK-10 D.E.O.