


T. 40S. R. 20E. W.M.

P 23661
46199

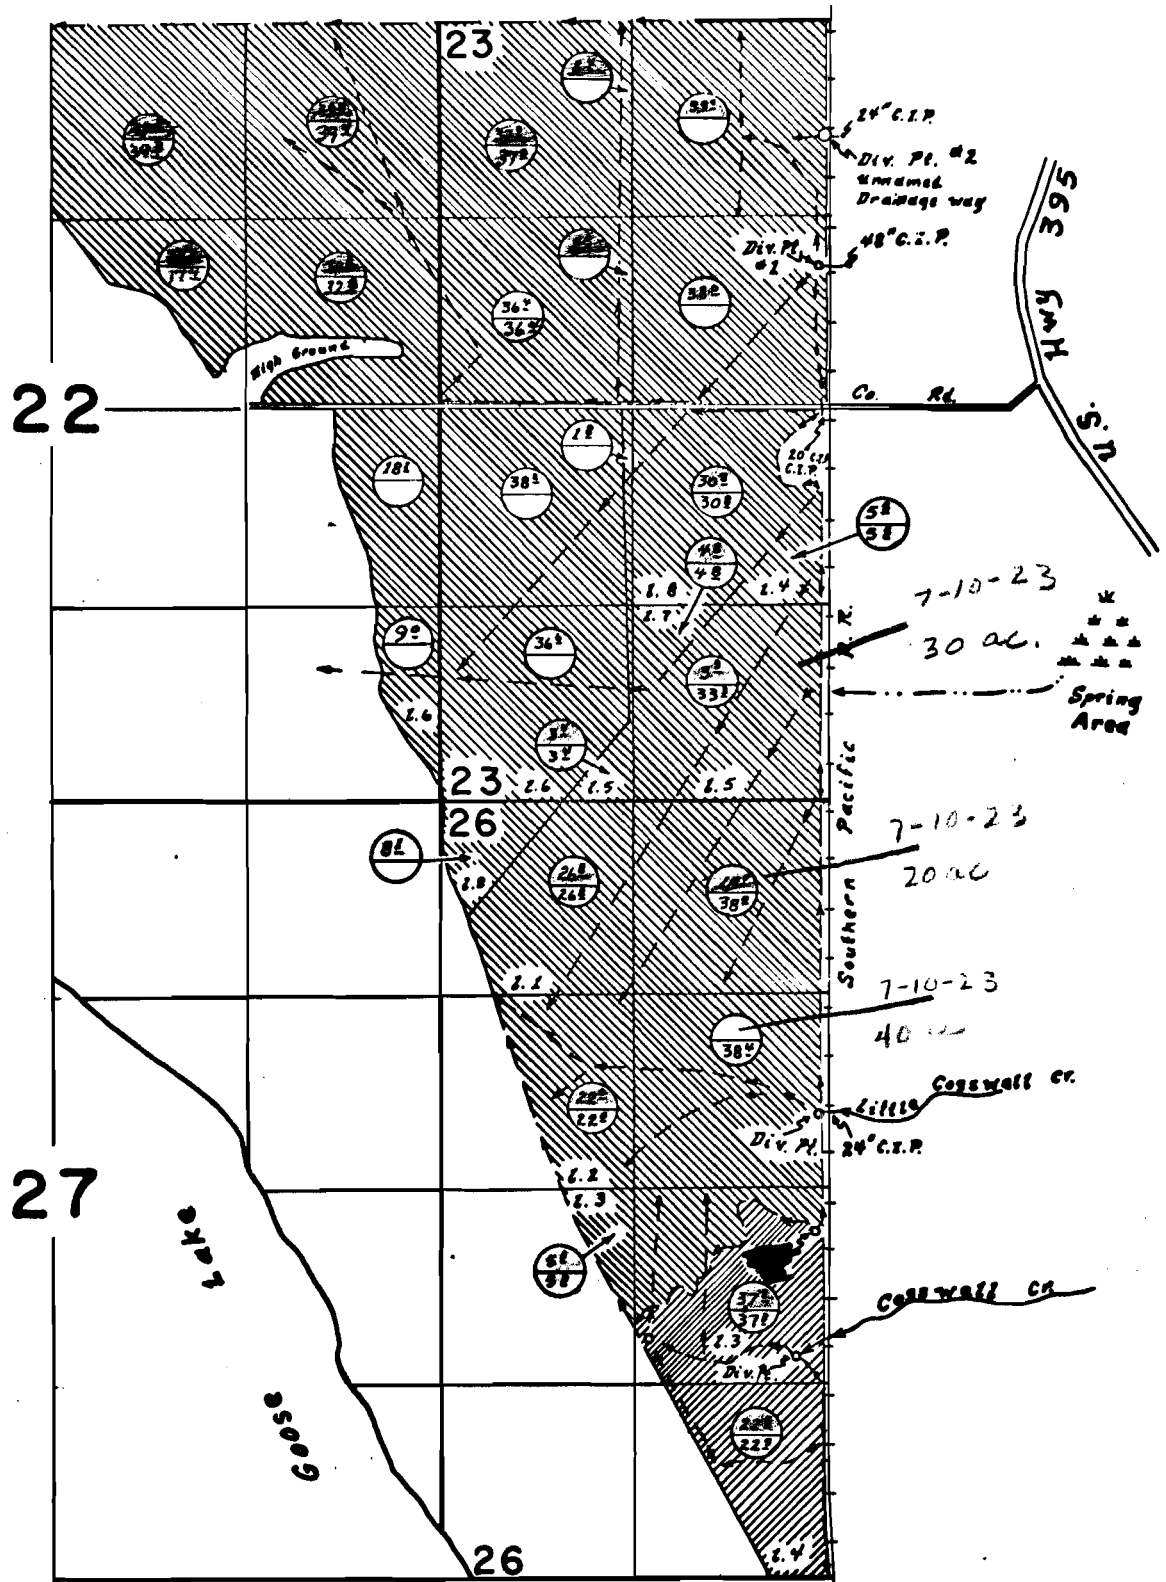

Div. Pt. from Coggswell Cr. loc. 1500' N. & 220' W. from S. & W. Cor. Sec. 26
Div. Pt. #1 loc. 970' N. & 60' W. } from Center of Sec. 23
Div. Pt. #2 loc. 1870' N. & 40' W. }
Well #1 loc. 2930' S. & 60' W. from S. & W. Cor. Sec. 23

FINAL PROOF SURVEY UNDER

See P#5949

G-2717
27339

G-2587
25881

Primary
Supplemental

Application No. 39157 Permit No. 29344
IN NAME OF

Neal Elliott

Surveyed 20 Sept. 1972 by I.E. Gould