


T. 40S. R. 19E. W.M.

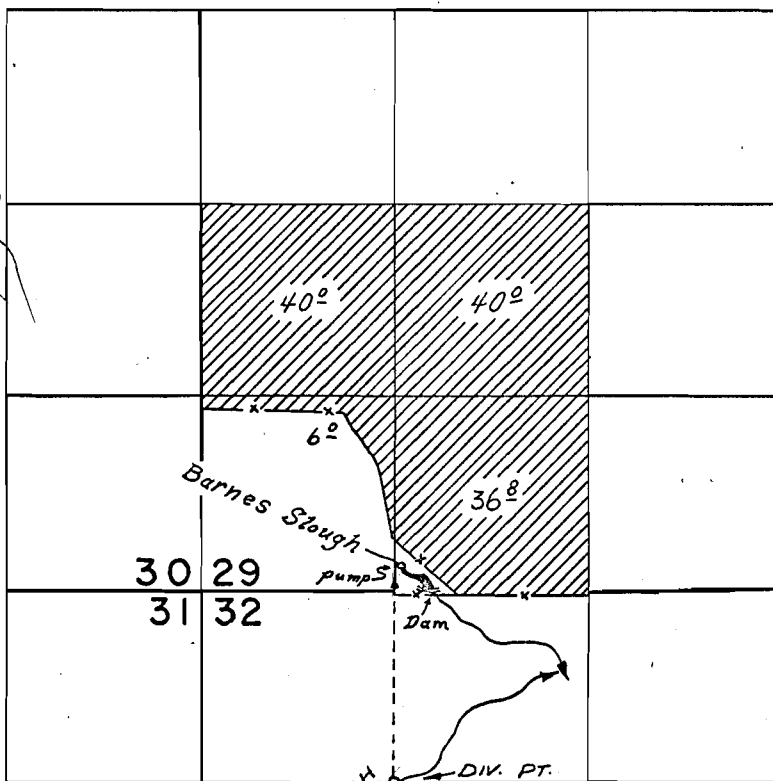

DIV. PT. LOC: 1320'S & 1320'E FROM
NW. COR. SEC. 32

UNNAMED SLOUGH
DIV. PT.

FINAL PROOF SURVEY UNDER

Application No. 42144 Permit No. 31516
IN NAME OF

George T. Fenimore

Surveyed 29 Sept 1972, by L.E. Gould

40-19 ✓