


T. 40 S. R. 19 E. W. M.

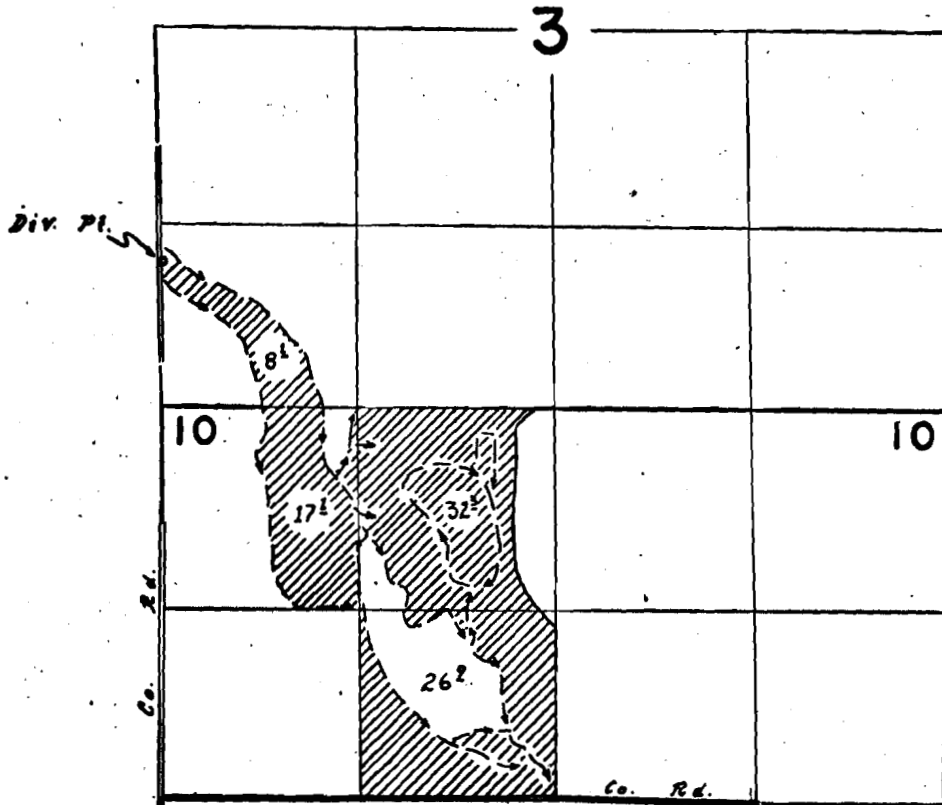

Div. Pt. Sec. 980' N. of 20' E. from S.W. cor. Sec. 3

FINAL PROOF SURVEY UNDER

Application No. 47540 Permit No. 35598
IN NAME OF

Carl A. Peay

Surveyed 19 Sept 1972, by L. E. Gould

40-19 ✓