


T.6S., R.10W., W.M.

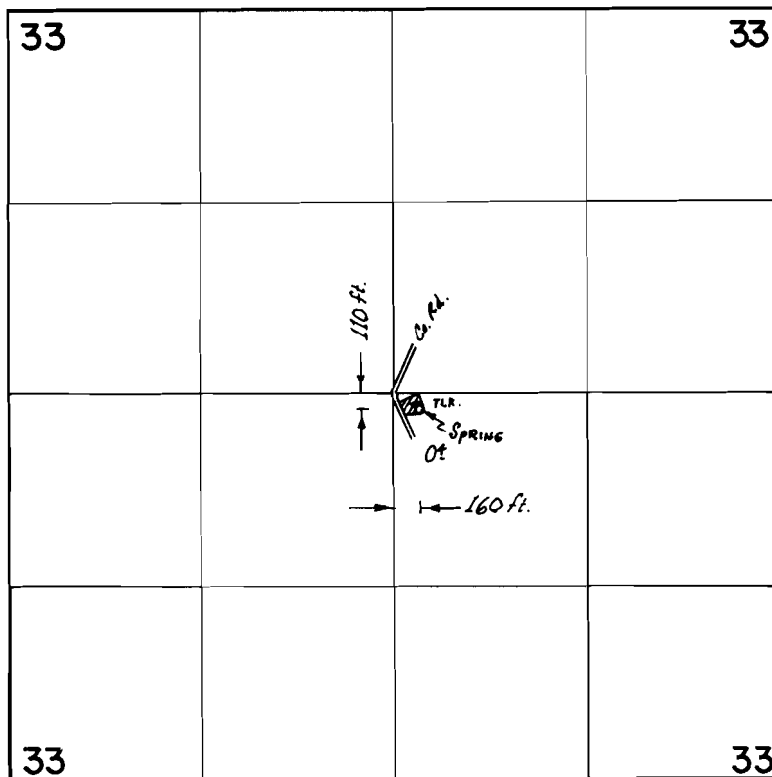

**FINAL PROOF SURVEY**  
UNDER

Application No. 47244 Permit No. 35387  
IN NAME OF

JACK & LOUISE RYAN LEWIS

Surveyed 22 Aug. 1972, by D. NORBY