


T.15S.R.3W.W.M.

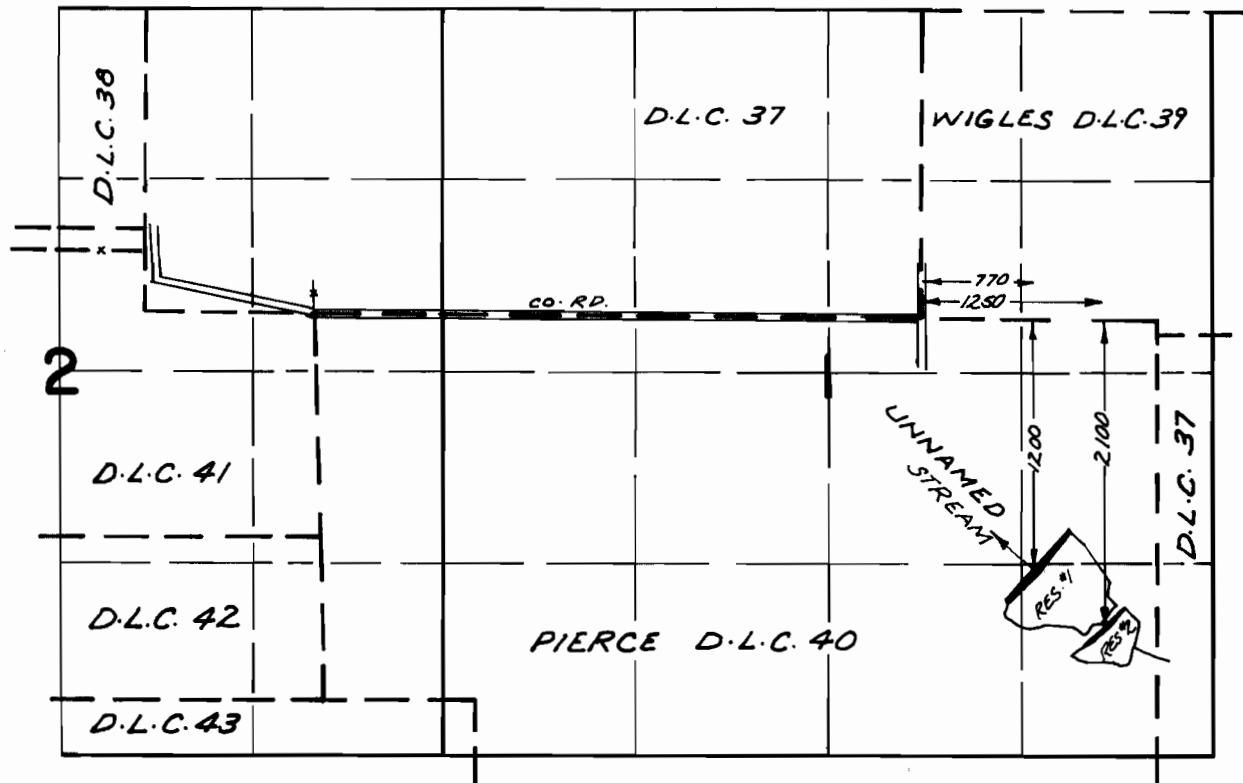

**FINAL PROOF SURVEY**  
UNDER

Application No. R-47544 R-5585  
47545 Permit No. 34858  
IN NAME OF

W. D. & NORMA M. GANN

Surveyed OCT. 23, 1973, by R. MUCKEN