


T.15S.R.3W.W.M.

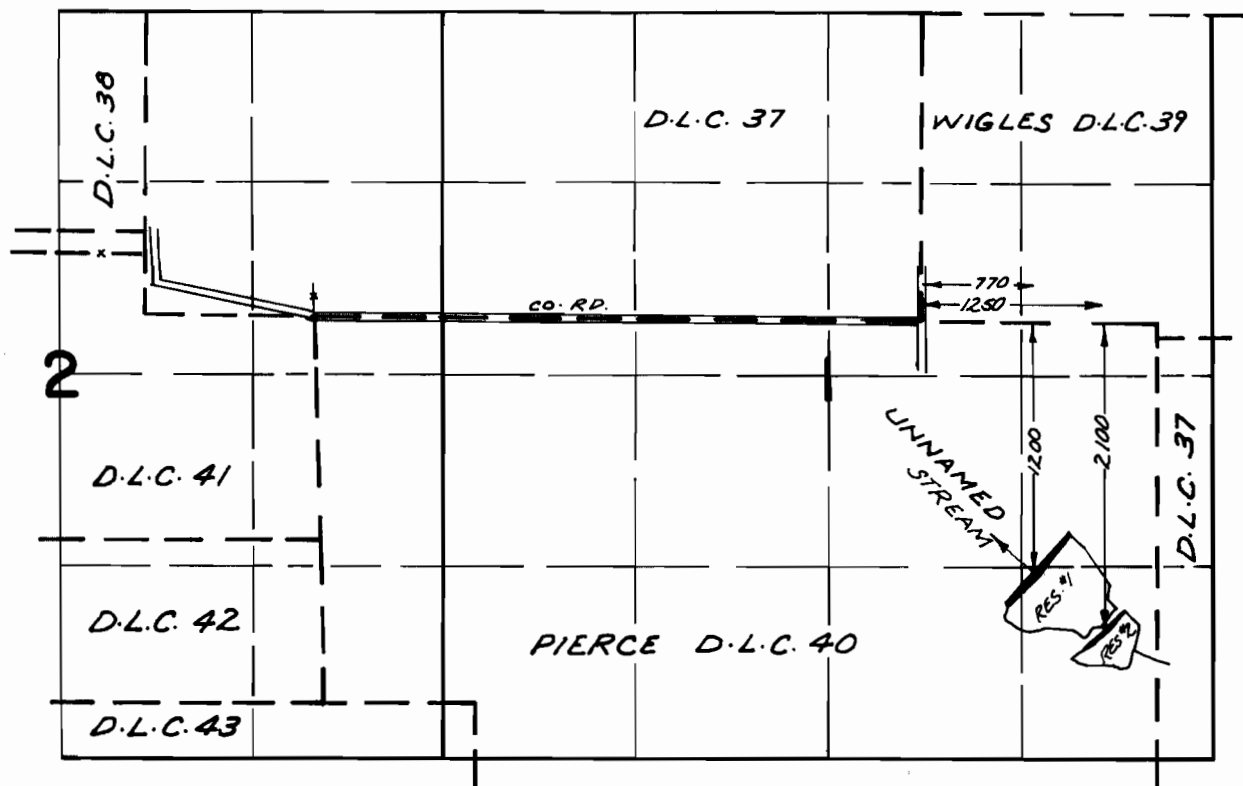

FINAL PROOF SURVEY
UNDER

Application No. R-47544 47545 Permit No. R-5585 34858
IN NAME OF

W. D. & NORMA M. GANN

Surveyed OCT. 23, 1973, by R. MUCKEN