


T. 7S. R. 18 & 2 W. W. M.

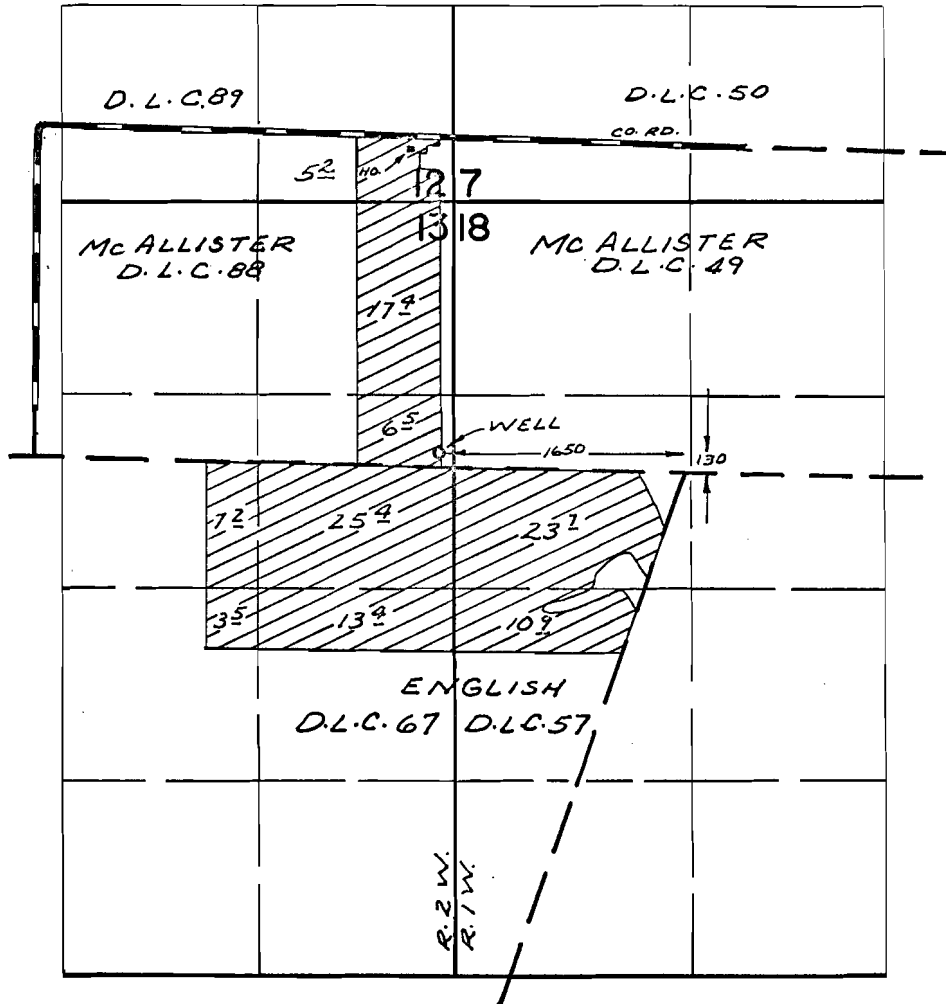


FINAL PROOF SURVEY UNDER

Application No. G-2944 Permit No. G-2771
IN NAME OF

HARLAN E. SCHURTER

Surveyed JUNE 2, 1972, by R. MURKEN

T.7S.R.1&2W.W.M.

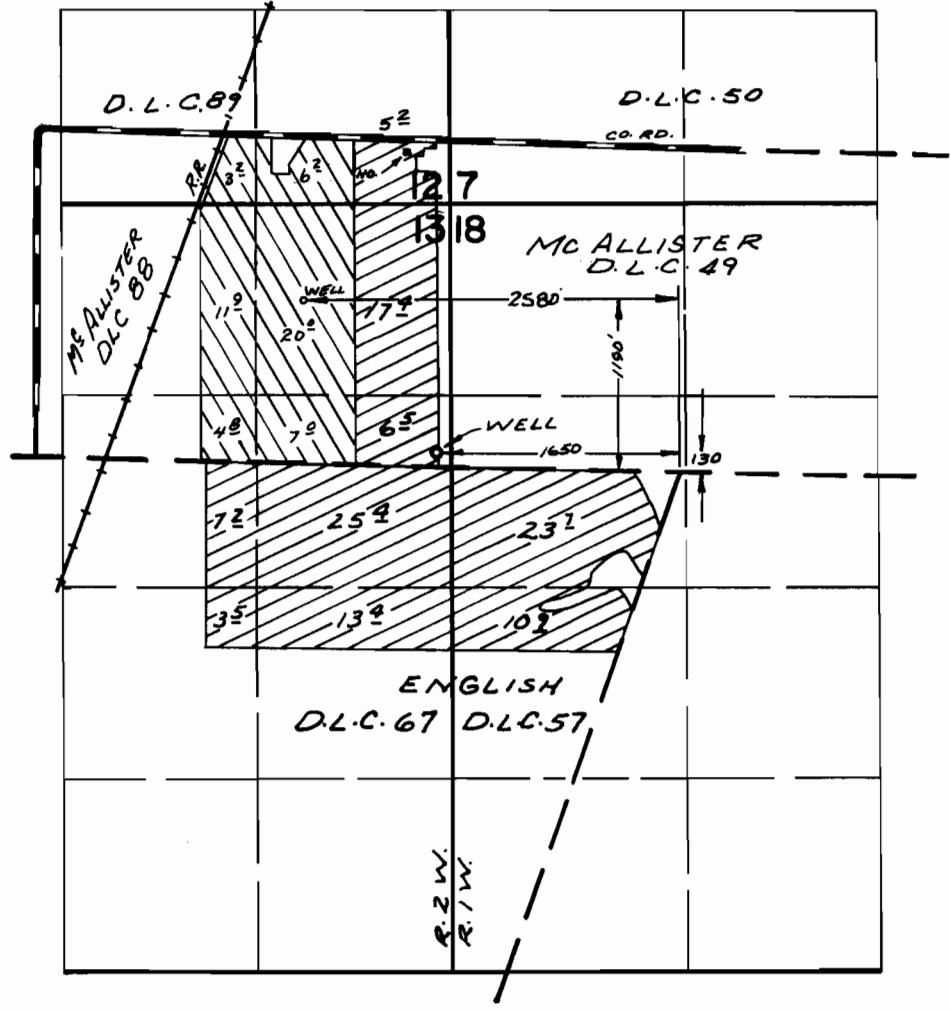

FINAL PROOF SURVEY UNDER

Application No. G-2744 Permit No. G-2771 
IN NAME OF

.....HARLAN E. SCHURTER.....

Surveyed JUNE 2, 1972, by R. MUGKEN
MAY 21, 1976 L. TOLL