


T. 3 & 4 S. R. 1 W. W. M.

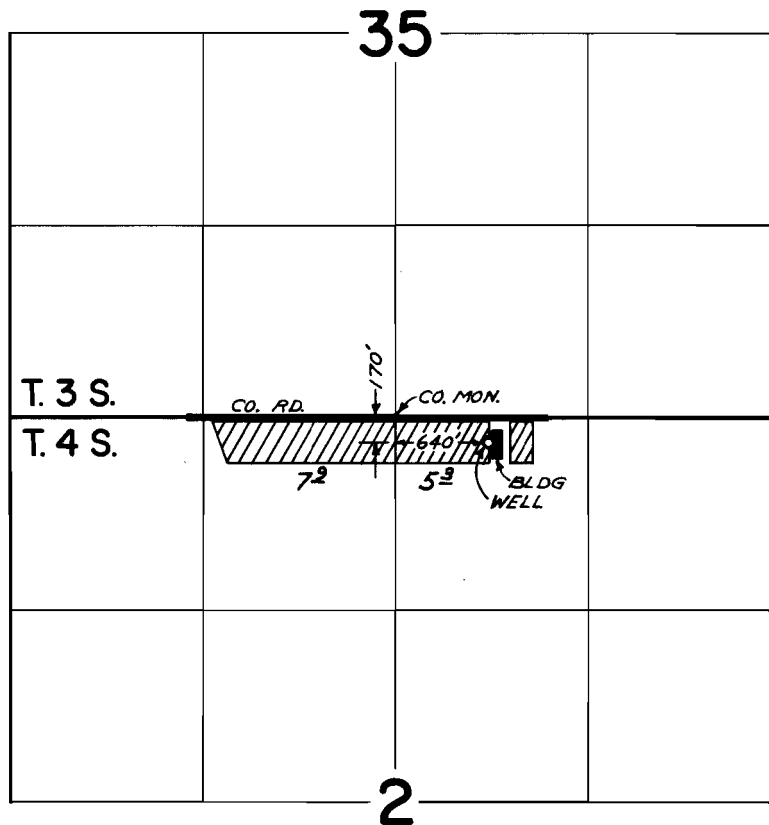

FINAL PROOF SURVEY
UNDER

Application No. G-3592 Permit No. G-3380
IN NAME OF

NORMAN J. McDONALD

Surveyed JUNE 3 1971, by GREG BACA