


# T.9S. R.2W. W.M.

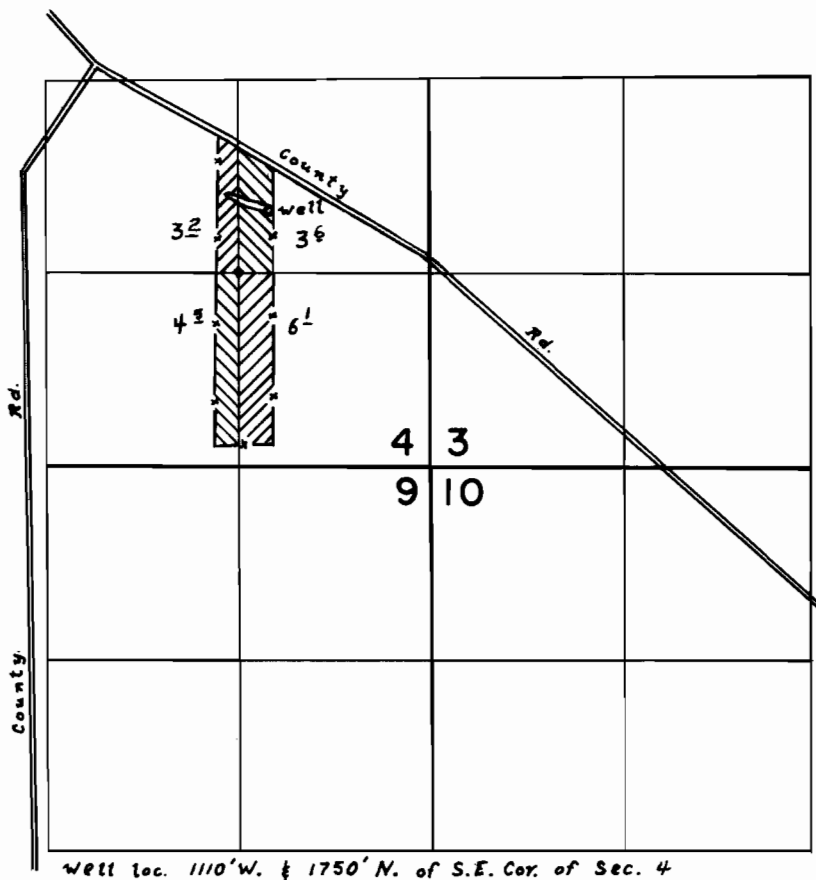

## FINAL PROOF SURVEY UNDER

Application No. G-4027 Record No. G-3778  
IN NAME OF

Annabell & Ollie Runions

Surveyed 20 OCT 1972, by D. O'Reilly